
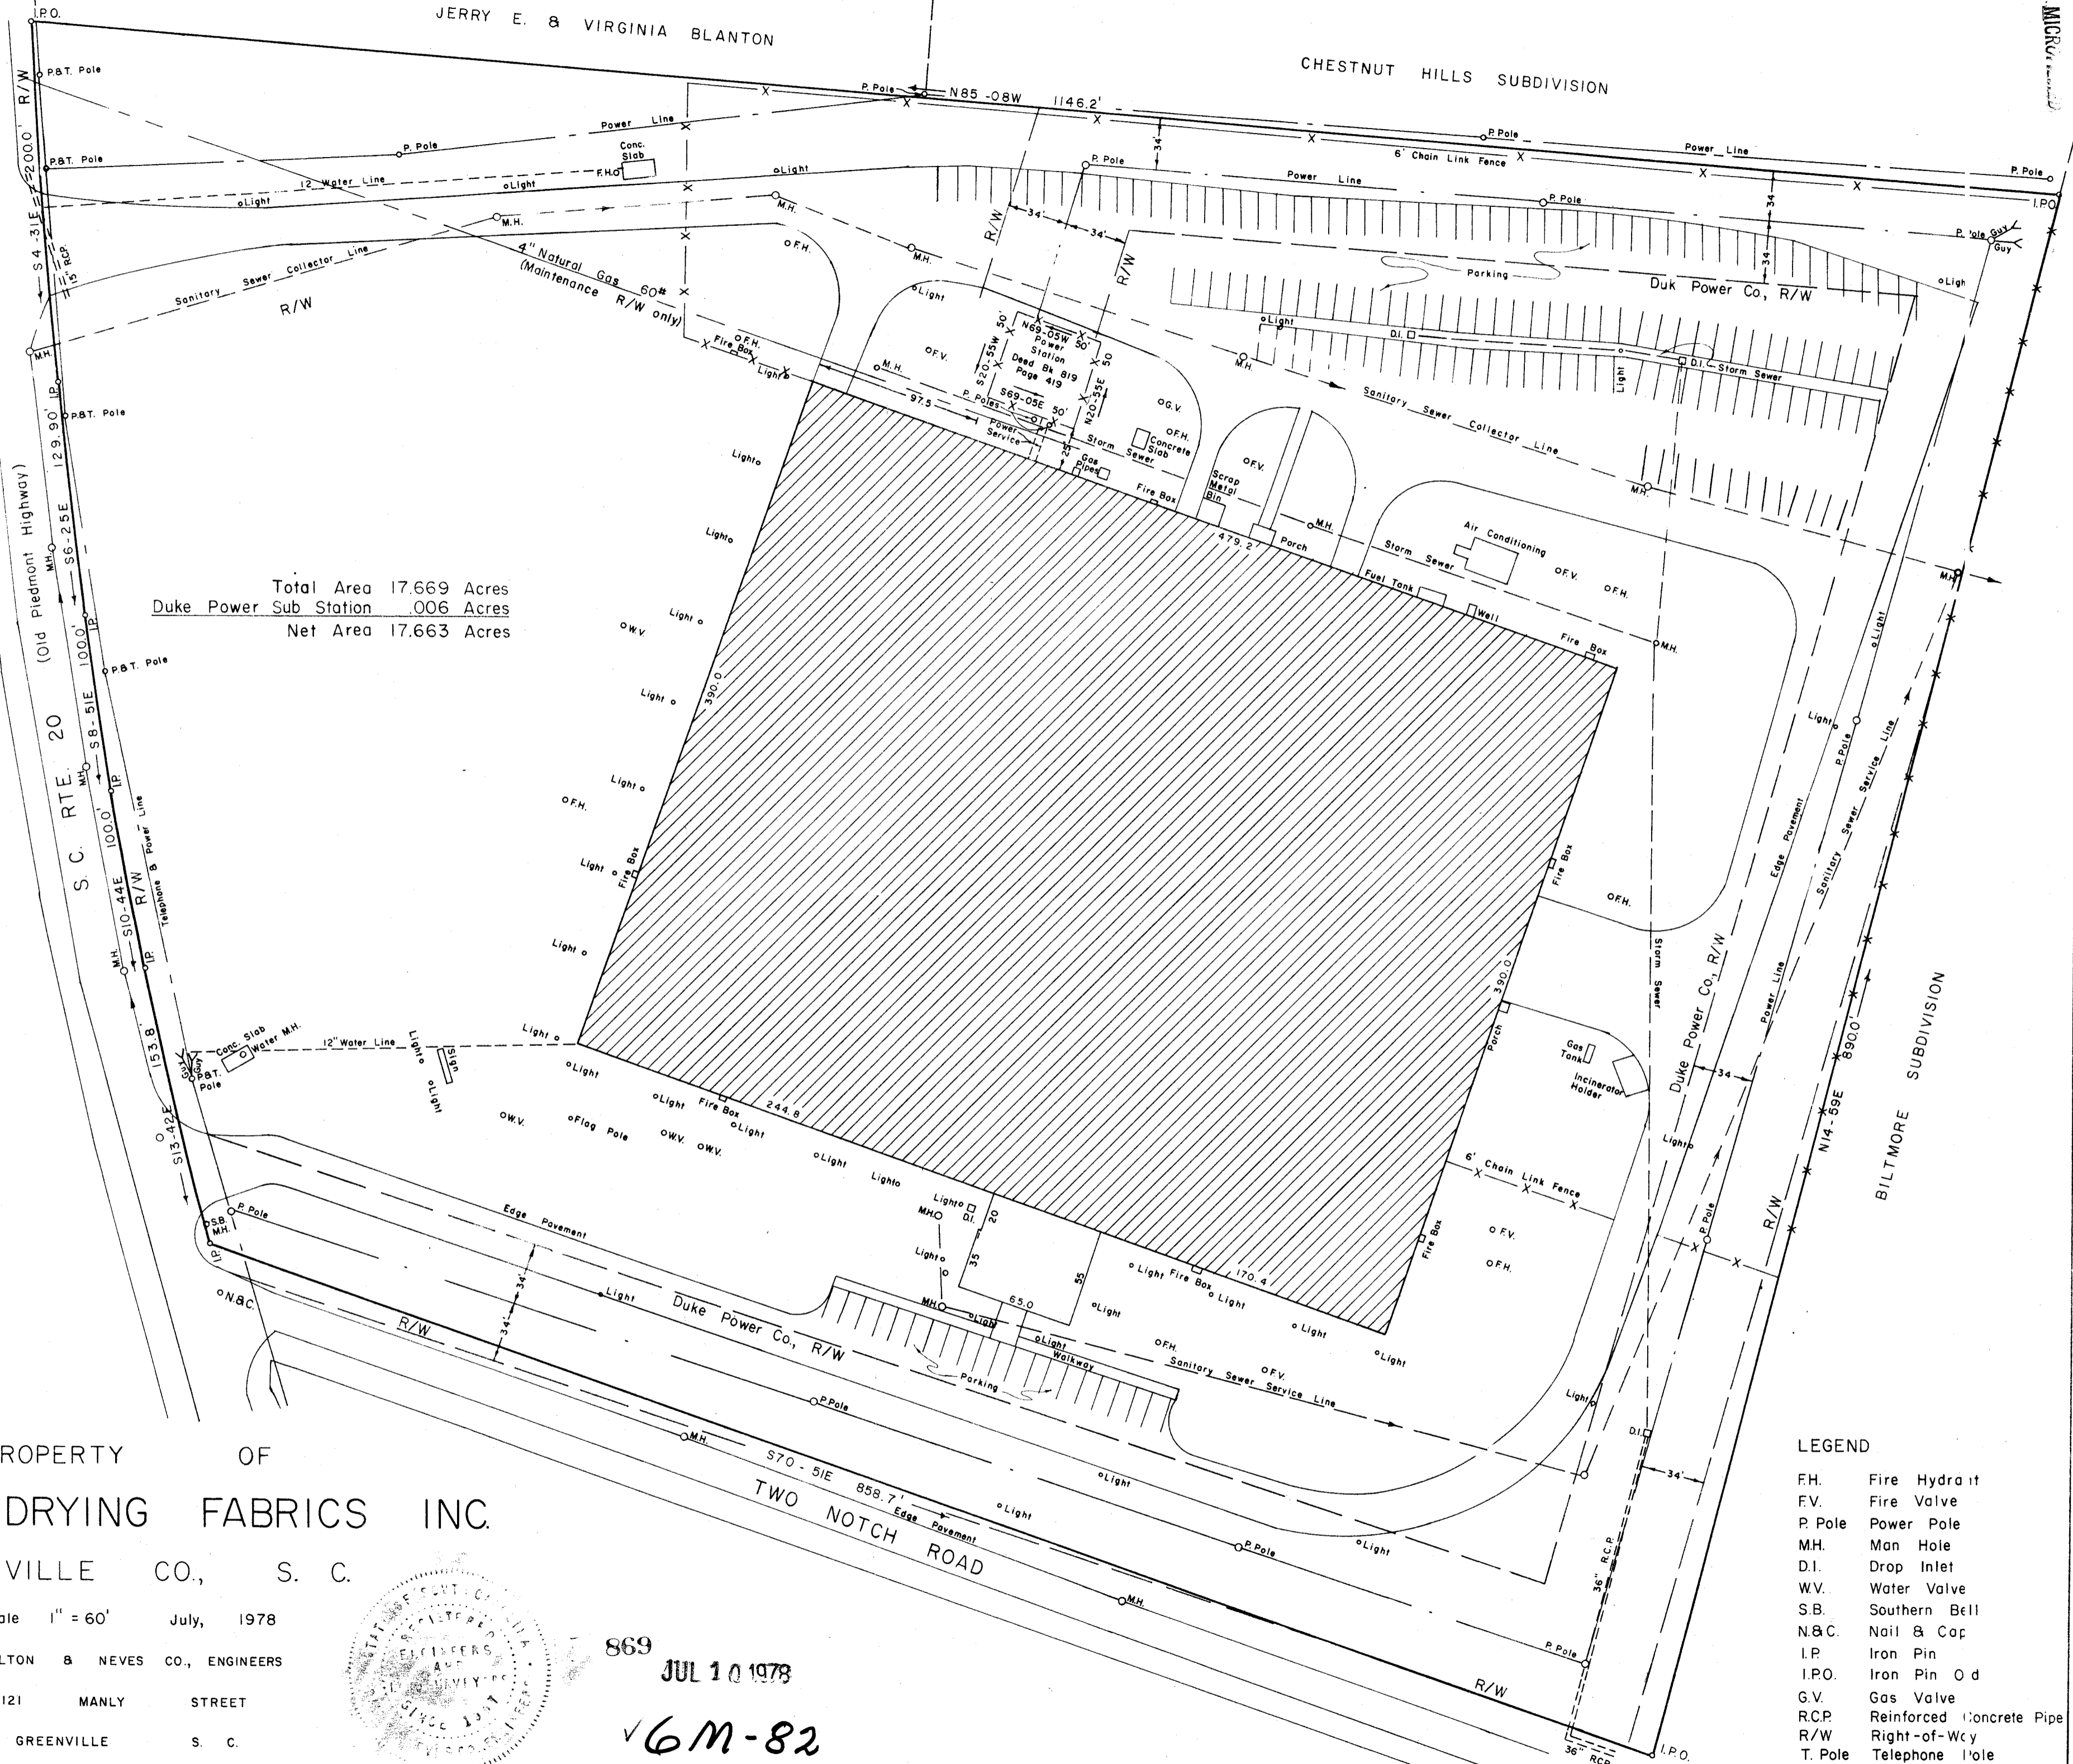


FILED
GREENVILLE CO. S. C.
JUL 10 4 31 PM '78
DONNIE S. TANKERSLEY
R.M.C.

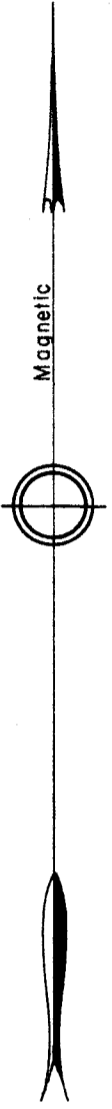

Total Area 17.669 Acres
Duke Power Sub Station .006 Acres
Net Area 17.663 Acres

FILED
GREENVILLE CO. S. C.
JUL 10 4 34 PM '78
DONNIE S. TANKERSLEY
R.M.C.

PROPERTY OF
BRANDON DRYING FABRICS INC.

GREENVILLE CO., S. C.

Scale 1" = 60' July, 1978

DALTON & NEVES CO., ENGINEERS

121 MANLY STREET

GREENVILLE S. C.



869 JUL 10 1978

✓ 6M-82

- LEGEND
- FH. Fire Hydrant
 - FV. Fire Valve
 - P. Pole Power Pole
 - M.H. Man Hole
 - D.I. Drop Inlet
 - W.V. Water Valve
 - S.B. Southern Bell
 - N.&C. Nail & Cap
 - I.P. Iron Pin
 - I.P.O. Iron Pin O d
 - G.V. Gas Valve
 - R.C.P. Reinforced Concrete Pipe
 - R/W Right-of-Way
 - T. Pole Telephone Pole