


1.0001

CAPLIM CIRCLE  
WATER & SEWER IN ST. RW  
2 AP 3 78 719

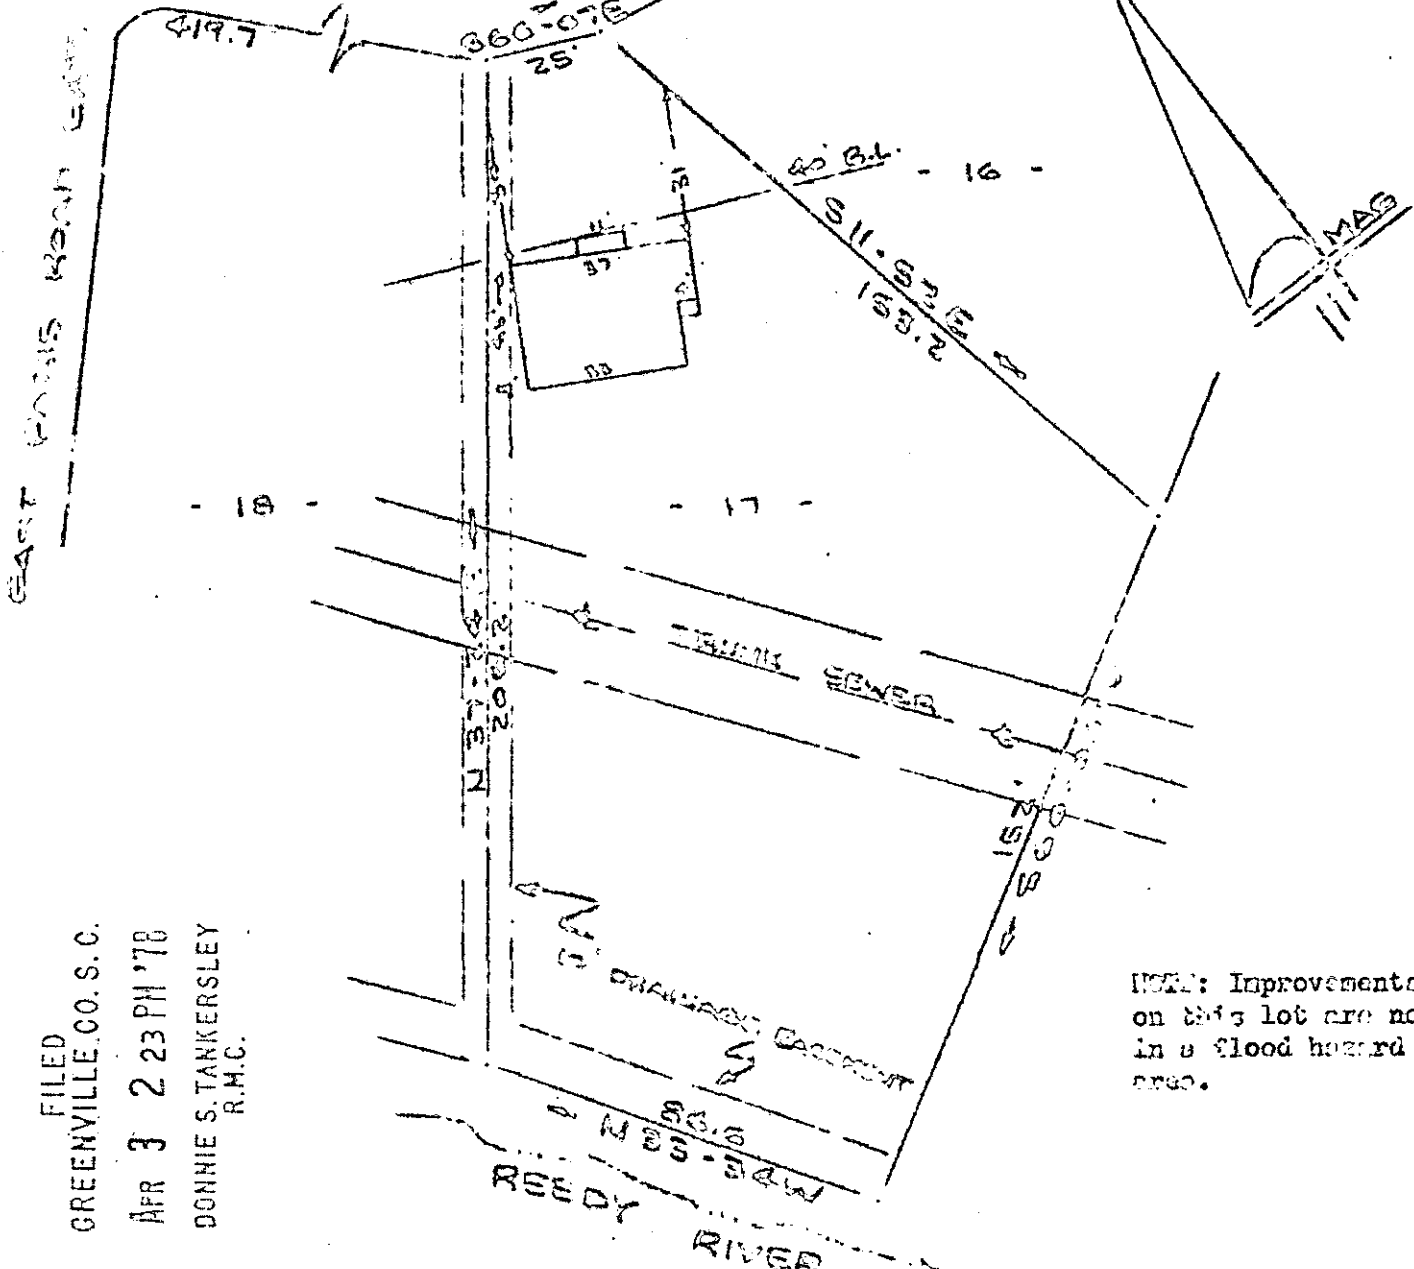

NOTE: Improvements on this lot are not in a flood hazard area.

FILED  
GREENVILLE, CO. S. C.  
APR 3 2 23 PM '78  
DONNIE S. TANKERSLEY  
R.M.C.

PROPERTY OF JOSEPH GATEWOOD & SARA LOUISE I. GATEWOOD

GREENVILLE, SOUTH CAROLINA  
GREENVILLE, SOUTH CAROLINA

I do hereby certify that on the 9th day of March, 1978, I surveyed the property shown on this plat, being known as lot 17 on plat of HILL PARK and recorded in the REC Office Greenville County, S. C., in Plat Book "VI" at Page 11; and that the property lines, walls and buildings are as shown hereon, and that the walls and buildings located on said lot do not encroach or project on adjacent street or property, and that no adjacent walls or buildings encroach or project on said premises, and no power lines cross this property except as shown hereon.

16-0-9

29188

B. B. Bruce  
B. B. Bruce, NLS

CAROLINA SURVEYING CO. MICROFILMED  
117 Main St. Greenville, S.C. 29601  
267-2-37

