


FILED
 GREENVILLE CO. S. C.
 MAY 29 11 16 AM '78
 DONNIE S. TANKERSLEY
 R.M.C.

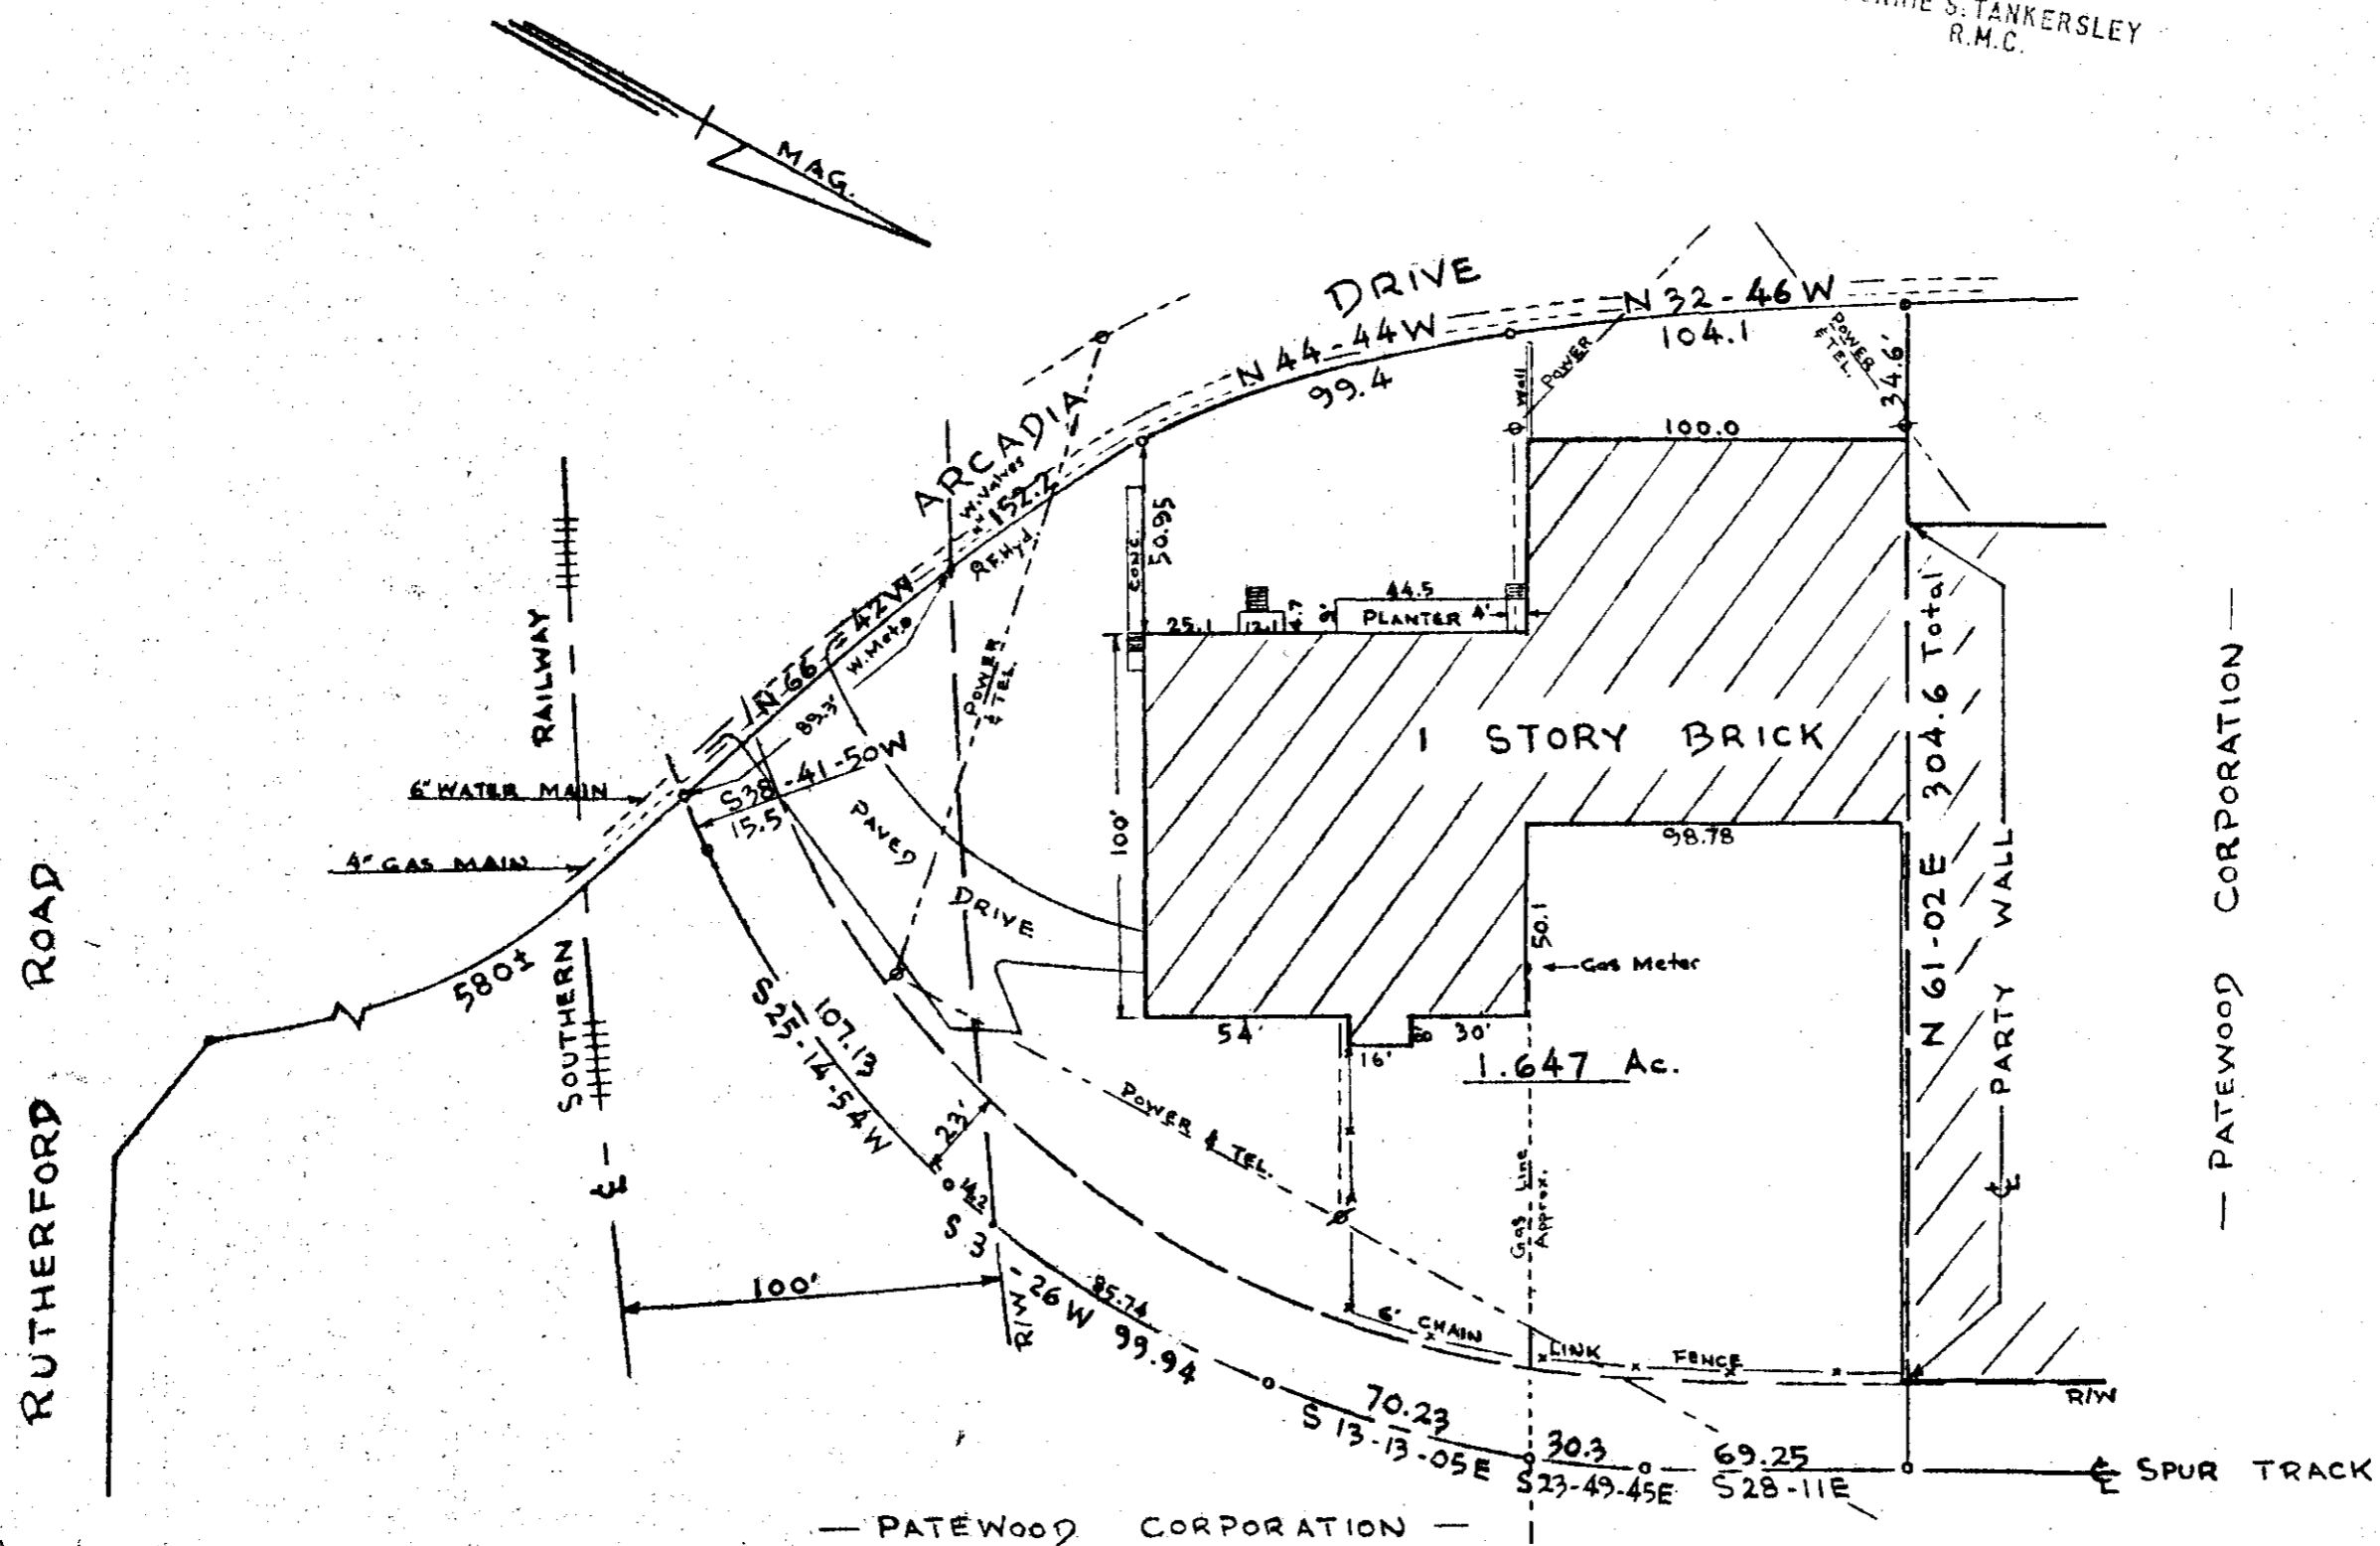

SURVEY FOR
 PATEWOOD CORPORATION

GREENVILLE CO., S.C.
 SCALE 1" = 50' MAY 18, 1978

I CERTIFY THE ABOVE SURVEY
 TO BE CORRECT.

James D. Crain
 JAMES D. CRAIN R.L.S. No. 3320

MAY 29 1978 ✓ 6-P-44

35480

PIEDMONT ENGINEERS ARCHITECTS & PLANNERS
 GREENVILLE, S.C.



GCTD -- 1 MAY 29 78 1353 2.00CI

MICROFILMED