


FILED
GREENVILLE CO. S. C.

JUL 3 4 43 PM '78

DONNIE S. TANKERSLEY
R.M.C.T.

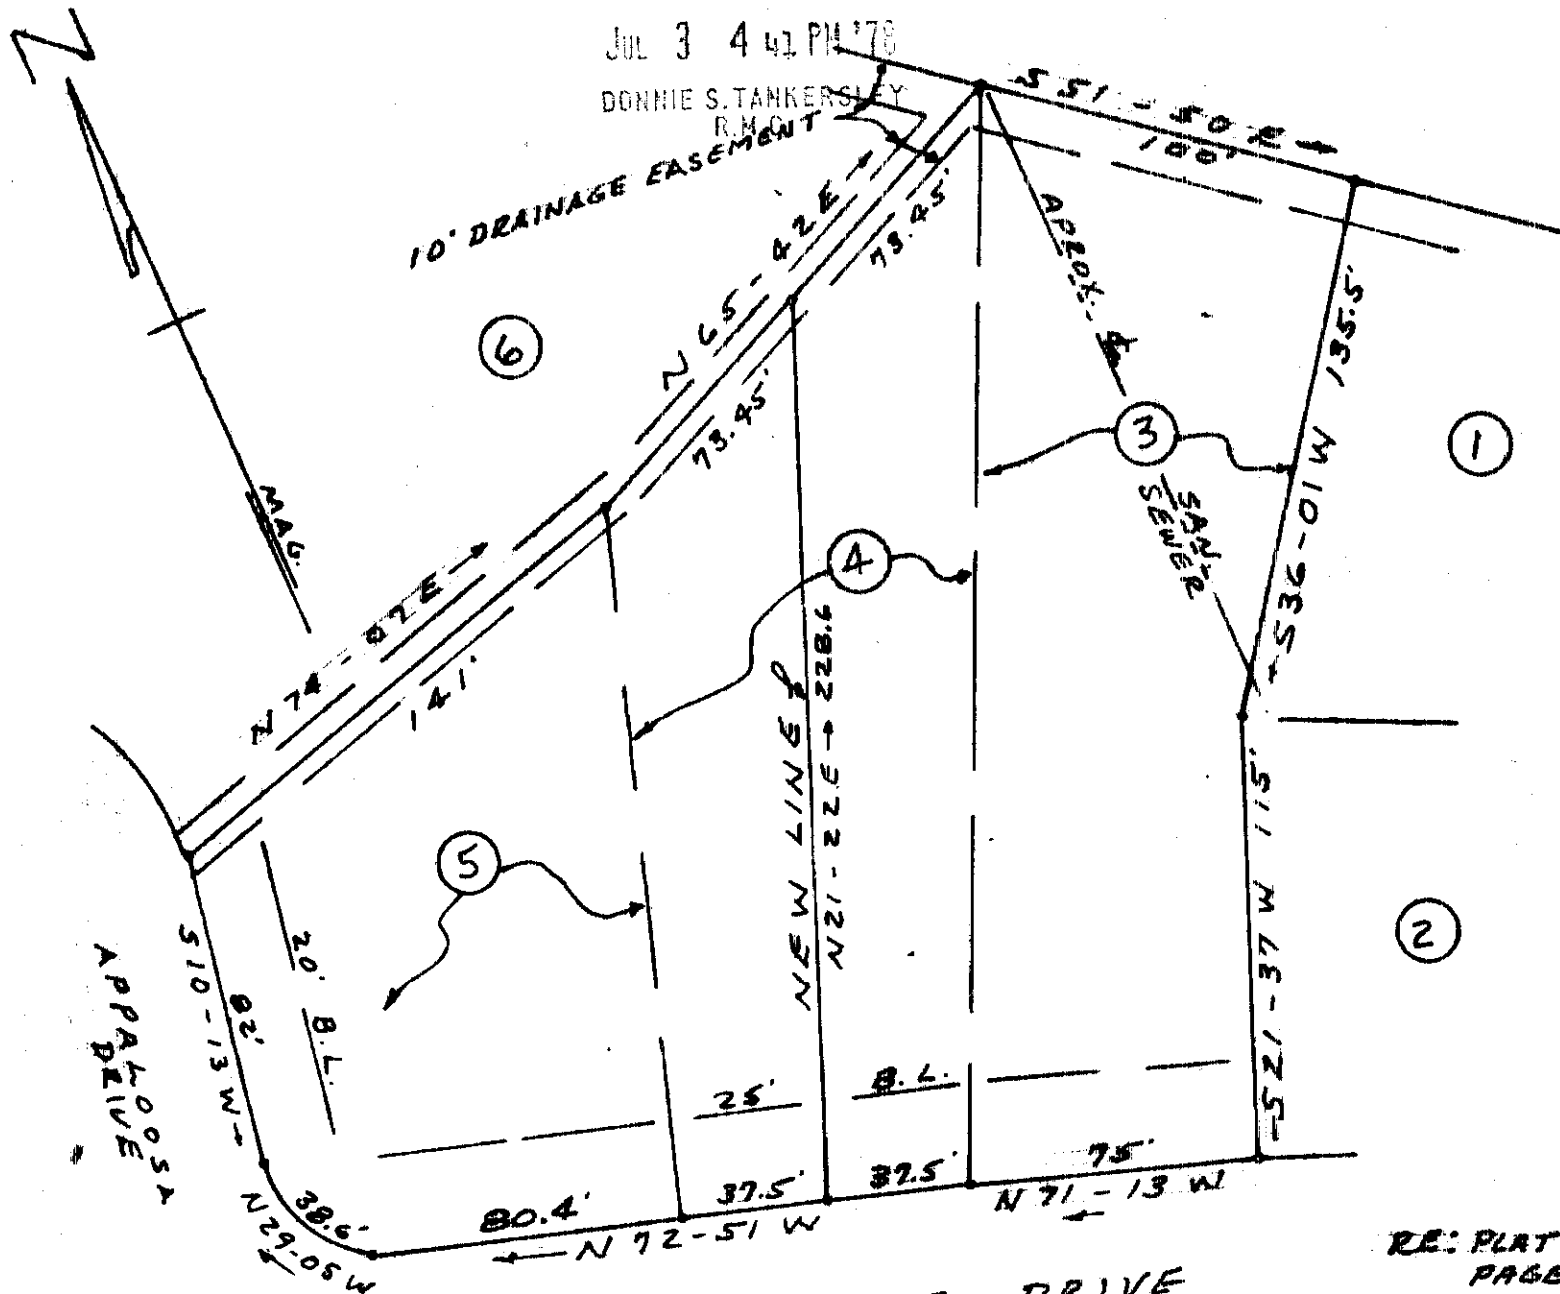

RE: PLAT BOOK TTT
PAGE NO 1

GETHSEMANE DRIVE

159


✓ 6-P 67 JUL 3 1978

THIS PLAT IS NOT A SUBDIVISION
AS DEFINED BY THE GREENVILLE
COUNTY SUBDIVISION REGULATIONS.

6/19/1978

Royce J. Carter
Chairman, Secretary, or Director of
Planning.
Greenville County Planning Commission

REVISION LOTS 3-4-5
MUSTANG VILLAGE
GREENVILLE CO., S. C.
JUNE 15, 1978 SCALE 1"=50'

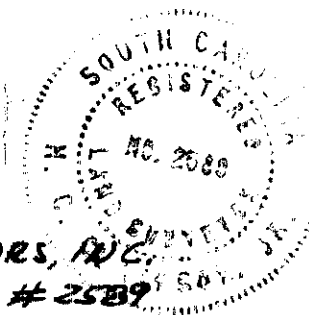

BY: CAMPBELL & CLARKSON, SURVEYORS, INC.
H. C. Clarkson, Jr. S.C.R.L.S. # 2589

MICROFILMED

GCTO --- JUL 3 1978
GCTO --- JUL 3 1978

736

1.000CI
1.000CI