


FILED
GREENVILLE CO. S. C.
JUL 17 10 18 AM '78
DONNIE S. TANKERSLEY
R.M.C.

MICROFILMED

EAST LAKE SHORE DRIVE

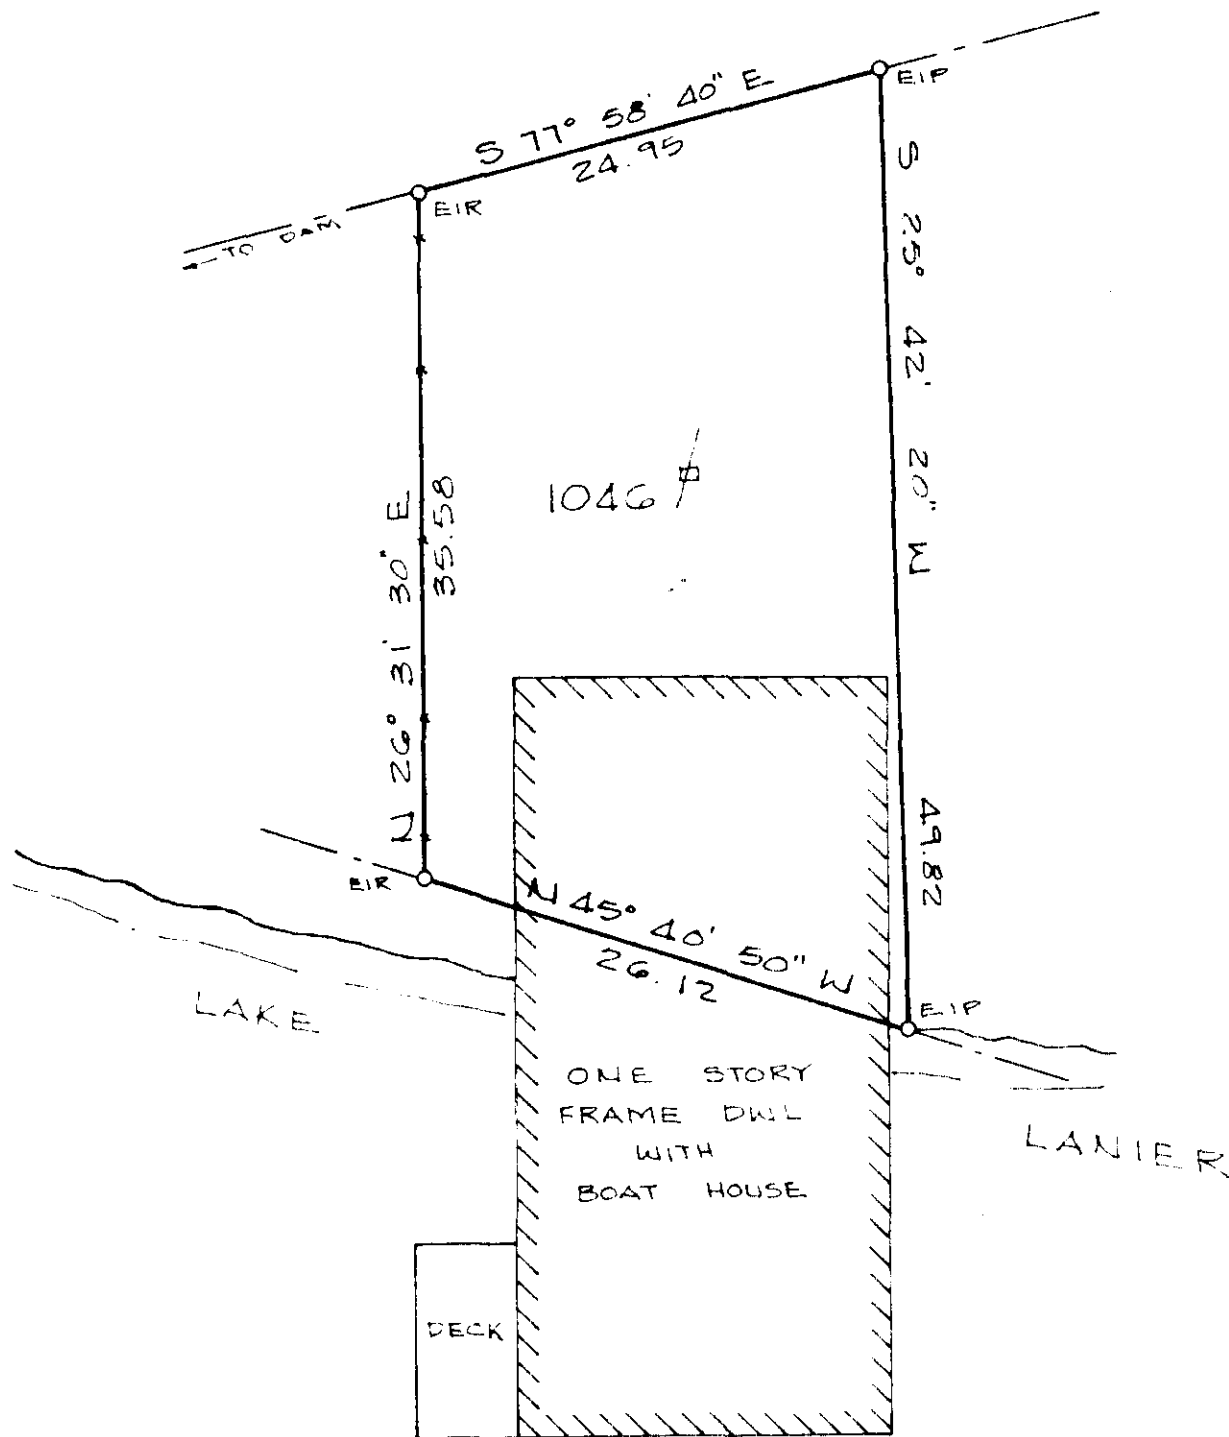

C. A. PRUETTE

GLASSY MT. TWP. GREENVILLE CO., S.C.

LEGAL REFERENCE PLAT BOOK RR Pg 8

SCALE: 1" = 10'




1 MAY 1978

SAM T. MARLOWE & ASSOCIATES

REG. LAND SURVEYOR 5549

COLUMBUS, NO. CAR.

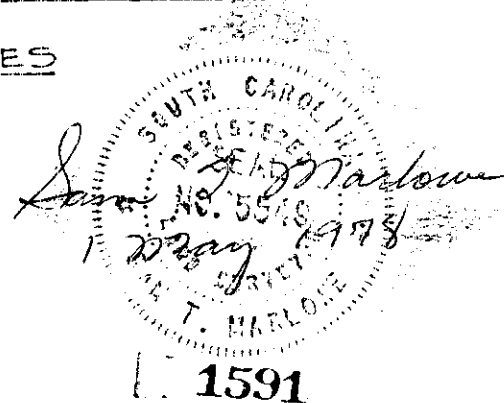

6-P-71

SCS 1778 1521

2.0001