MICROFILMED

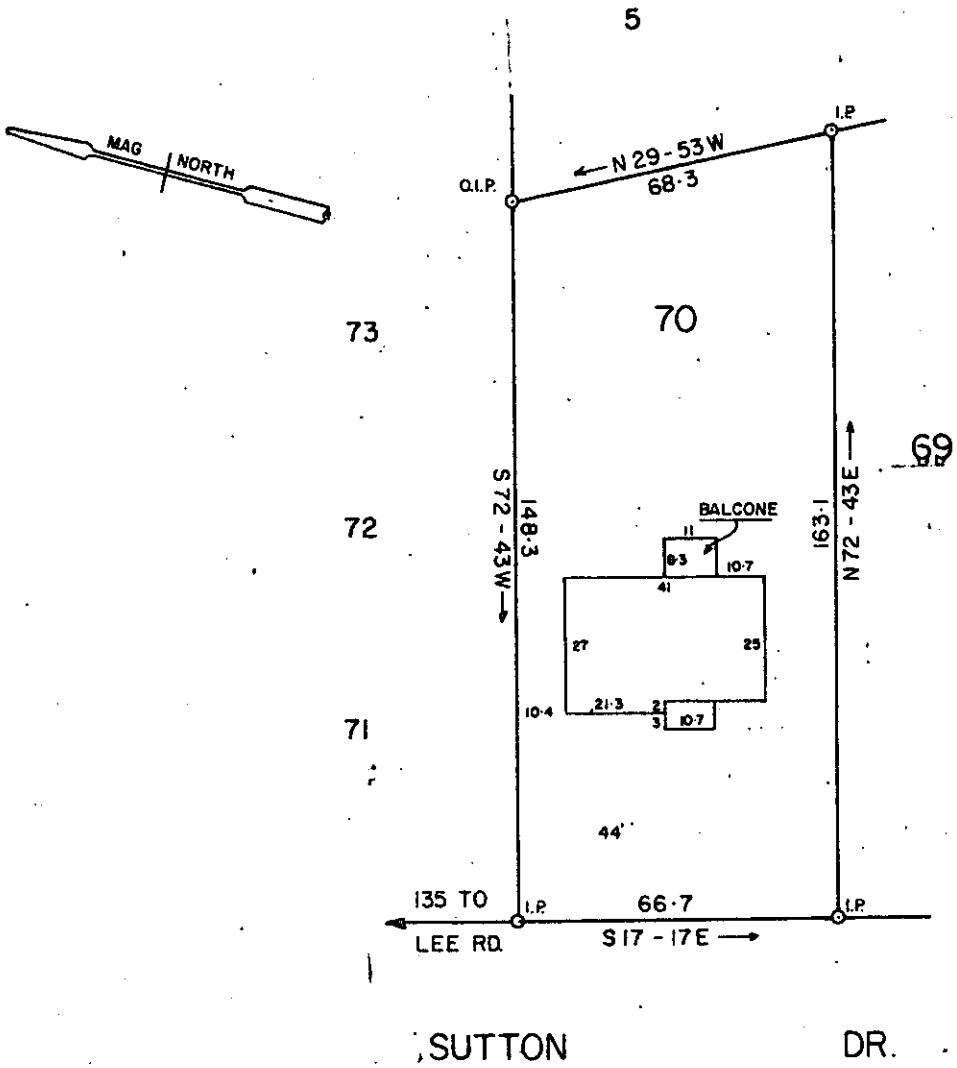

NOTE: THIS LOT DOES NOT LIE IN A FLOOD PLANE.

FILED
GREENVILLE CO. S. C.
MAY 25 4 35 PM '78
DONNIE S. TANKERSLEY
R.M.C.

6-Q-51 35267

This is to certify that on the 24 day of MAY, 1978, I surveyed the property shown on this plat, being BLOCK-D- LOT 70 & PART OF 69 MAYFAIR EST., recorded in Plat Book 72 & 73, PAGE 160 of the R.M.C. Office for Greenville County, S. C., and that the property lines, walls and buildings are as shown hereon; that the buildings located on said lot do not encroach or project on adjacent streets or property; and that no adjacent buildings or walls encroach or project on said premises, and that no utility lines cross this property.

PROPERTY OF

JOHNNY G. HOLLOWAY

GREENVILLE COUNTY, S.C.

SCALE 1"=40'-MAY-24-1978

GCIO 3 MY 25 78 1160 1.00CI

Reg. Engineer No. 1144 S.C.

JONES ENGINEERING SERVICE 1004 E. PERRY RD.