

MICROFILMED

WATKINS ROAD

FAIRLAWN CIRCLE
WATER & SEWER IN ST. RW


605.1

517-12E

556-23SE

50'

30'
BL

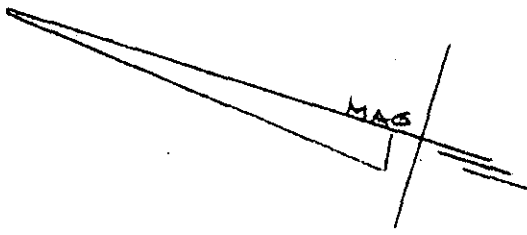

NOTE: Improvements on this lot are not in a flood hazard area.

-4-

PT LOTS 5 & 6

N85-45E
219.9

176.9
155-22W
SEWER

POWER LINE RW

185.1

N35-46W

36241

✓6-Q-63

PROPERTY OF
BARRY. PARIS & DONNA PARIS
NEAR GREENVILLE, S. C.
SCALE: 1" = 40'

30 MAY 1978

This is to certify that on the 30th day of May, I surveyed the property shown on this plat, being known as part of lots 5 & 6 on plat of SECTION TWO PENWICK HEIGHTS and recorded in the RMC Office Greenville County, S.C., in Plat Book "QQ" at Page 45 and also being known as PROPERTY OF BARRY PARIS & DONNA. PARIS and recorded in Plat Book at Page and that the property lines, walls and buildings are as shown hereon, and that the walls and buildings located on said lot do not encroach or project on adjacent street or property, and that no adjacent walls or buildings encroach or project on said premises, and no power lines cross this property except as shown hereon.

R. B. Bruce, RLS #1952

CAROLINA SURVEYING CO.
112 Manly St.

R. B. Bruce

82147 (5518)

Greenville, S. C.

B.2-1-297

10175

RECORDED
GREENVILLE, CO. S. C.
JUN 2 12 09 PM '78

DONNIE S. TANKERSLEY
R.M.C.

316

1.0001