


MICROFILMED

FILED
 GREENVILLE CO. S. C.
 JUN 27 10 25 AM 1978
 DONALD S. TURNER SEELY
 COUNTY CLERK

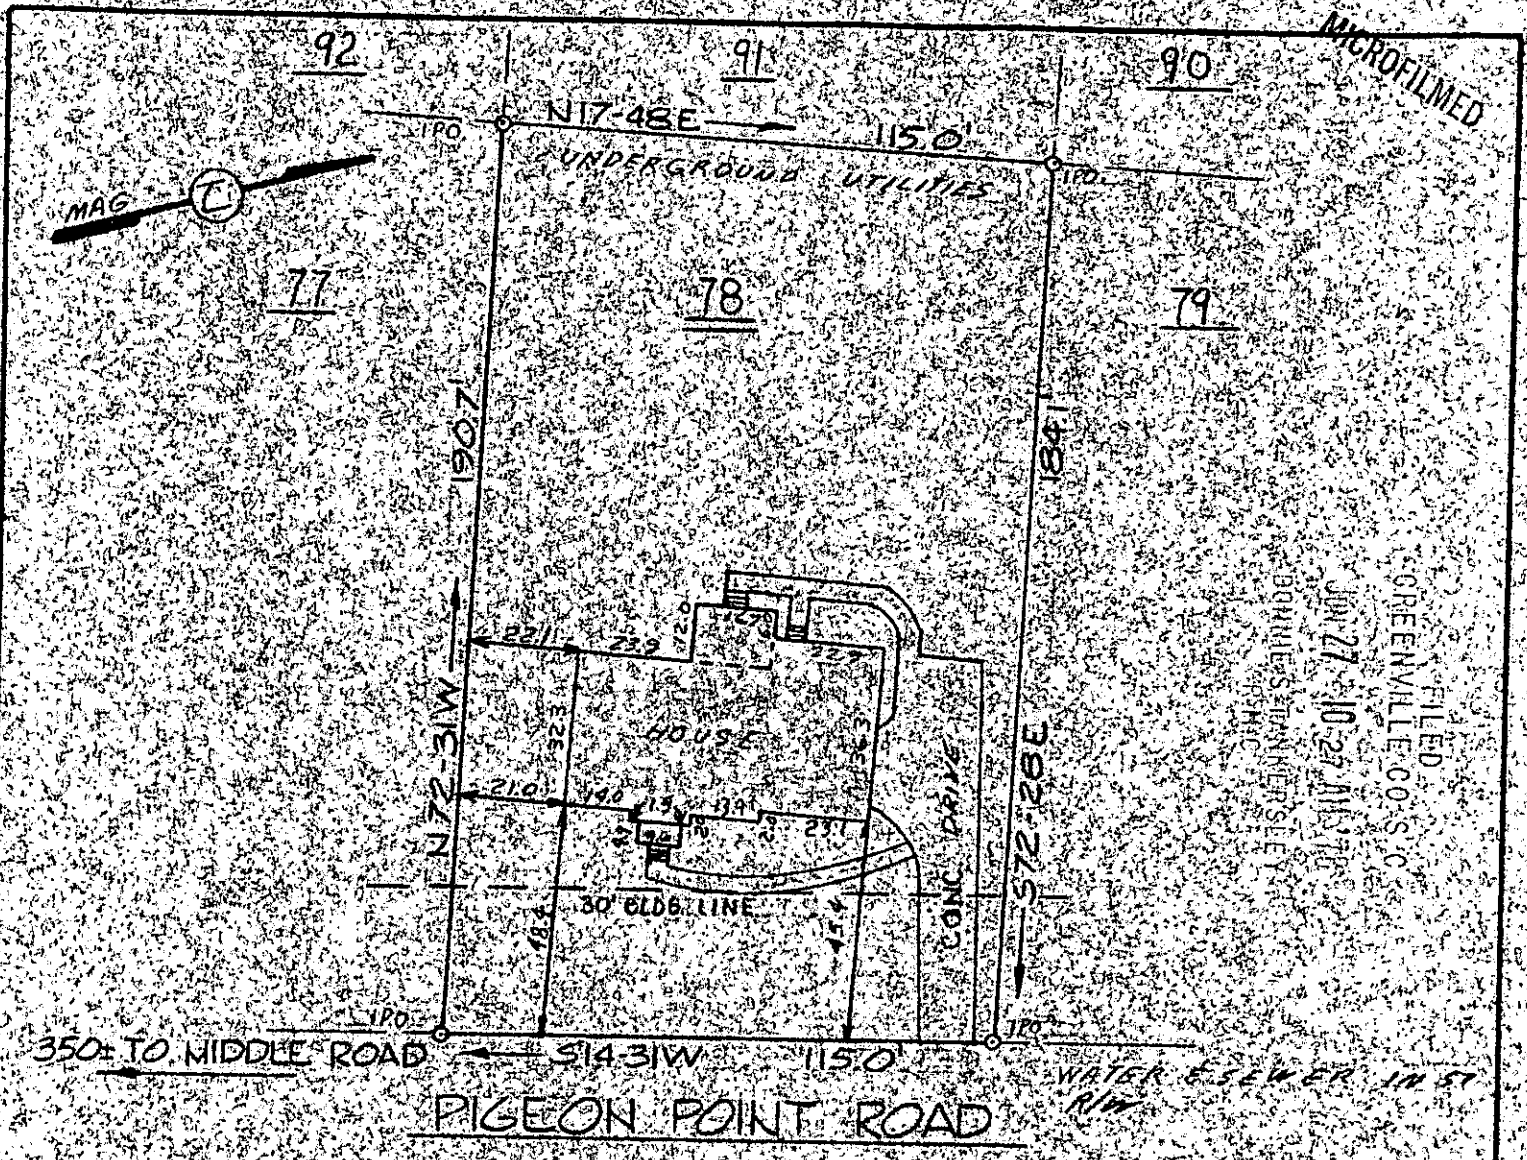

This is to certify that on June 14, 1978, I surveyed the property shown on this plat known as Lot 78 on Plat of Forrester Woods - Section 7, recorded in the R. M. C. Office of Greenville County in Plat Book 59 on Page 21, and that the property lines, walls and buildings are as shown hereon, and that the building located on said lot does not encroach or project on adjacent streets or property, and that no adjacent walls or buildings encroach or project on said premises, and that no utility lines cross this property except as shown hereon. This property is not located in a flood hazard area.

Note: there is a 5' drainage and utility easement each side of all side and rear lot lines.

James R. Freeland
 James R. Freeland PLS & PE 4781

NO. 2-1-173



STATE OF SOUTH CAROLINA
GREENVILLE COUNTY

FORRESTER WOODS
SECTION 7 - LOT 78

39070
 PROPERTY OF
GLENN N RONNING
 6
KAREN E RONNING

FREELAND & ASSOCIATES
 Engineers • Land Surveyors

GREENVILLE, S. C.

SURVEY	JRF
DRAWN	DC
CHECK	<i>[Signature]</i>
SCALE	1"=40'
DATE	6-15-78
DWG NO	78-2173

6-R-22

GC100-1 JUN 27 78 010 1 0001