FILED
GREENVILLE CO. S. C.
JUL 20 2 57 PM '78
DONNIE S. TANKERSLEY
R.M.C.

MICROFILMED

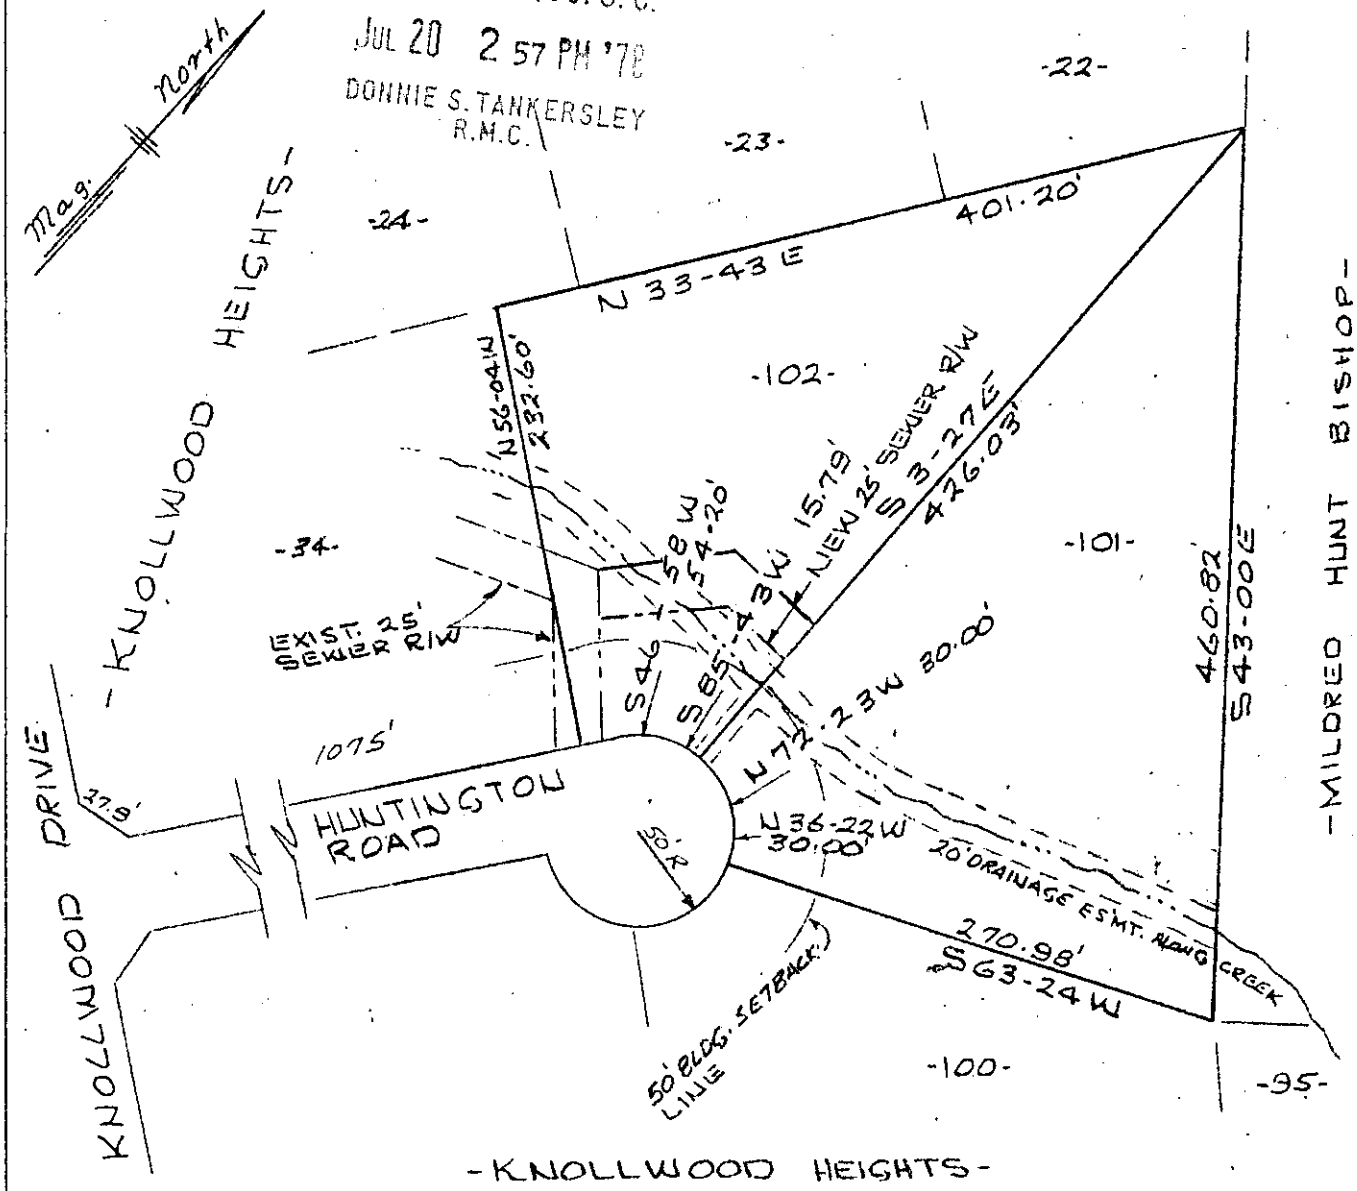

REVISION TO LOTS 101 & 102
KNOLLWOOD HEIGHTS ADDITION
GREENVILLE COUNTY, S. C.

SCALE 1" = 100' JUNE 10, 1978
REV. JULY 14, 1978

NOTE:
NEW 25' SEWER R/W ADDED - NOT SURVEYED - SEE SUBD. PLAT DATED 5-17-74

JUL 20 1978

6R-77

2139

PIEDMONT ENGINEERS - ARCHITECTS - PLANNERS
GREENVILLE, S. C.

COPY TO 2 JL20 78 875

1.00CI

10316