


MICROFILMED

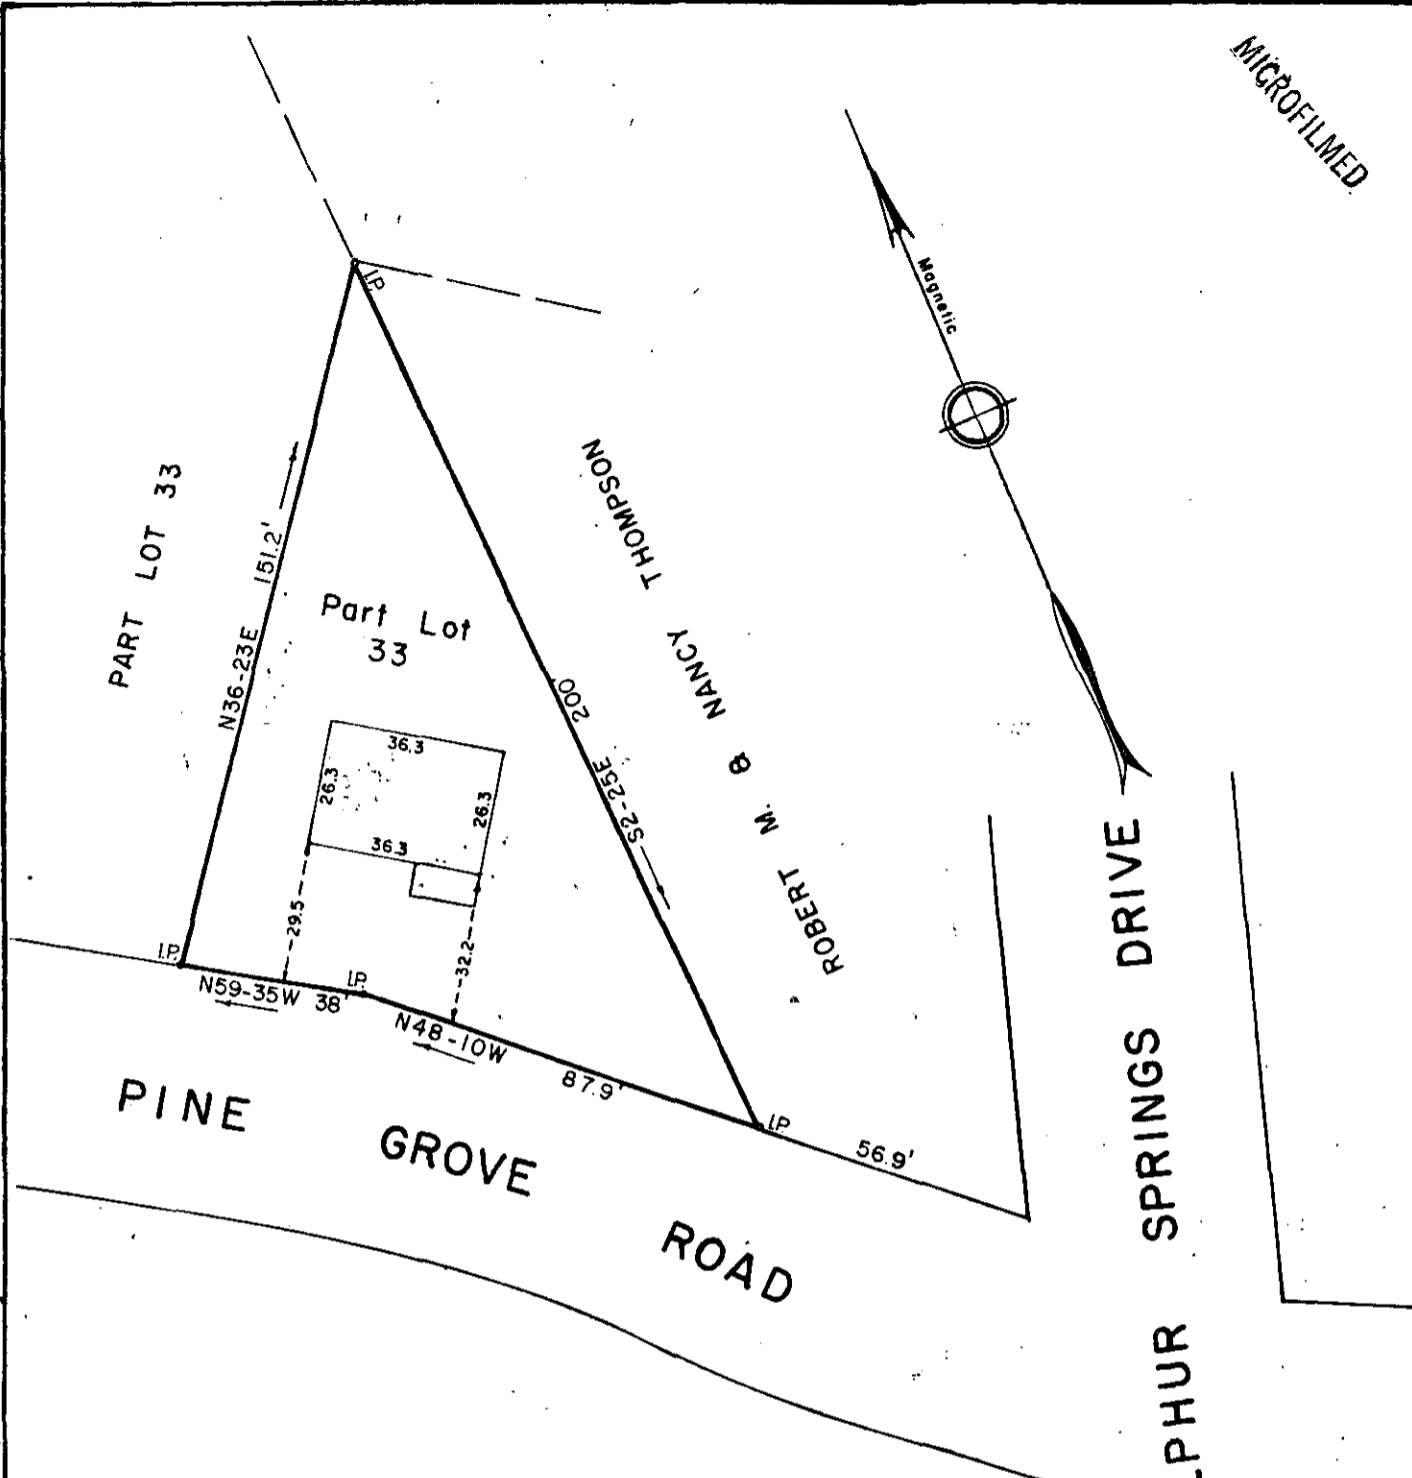

PROPERTY OF
DACE Z. TOMLINSON
 GREENVILLE CO., S.C.

Scale 1" = 40' July, 1978

2326

FILED
 GREENVILLE, CO. S.C.
 JUL 21 4 38 PM '78
 DONNIE S. TANKERSLEY
 R.M.C.

This is to certify that on the 20th day of July, 1978, We surveyed the property shown on this plat; being known as part of Lot 33 on plat of Extension Pine Grove Heights, Recorded in Plat Book SS page 83, Office of R. M. C. Greenville Co., S.C.; and that the property lines, walls, and buildings are as shown hereon; that the buildings located on said lots do not enroach or project on adjacent streets or property; and that no adjacent buildings or walls enroach or project on said premises; and from information from Greenville County, this structure is not in a designated flood area.



William B. Fant
 Dalton & Neves Co., Engineers

✓ 6-R-79

GCTO -- JUL 21 78 1186