

Note:  
Improvements on  
this lot are not  
in a flood hazard  
area.

FILED  
GREENVILLE CO. S. C.  
JUG 23 9 56 AM '78  
DORRIS S. TANKERSLEY  
R.M.C.

HEATHERLY DRIVE  
WATER & SEWER IN ST RM


PROPERTY OF  
LEROY DANIEL TIMS & BEVERLY LYNN TIMS  
NEAR GREENVILLE, S. C.  
SCALE: 1"=40' 22 AUG 1978

This is to certify that on the 27th day of August, 1978, I surveyed the property shown on this plat, being known as part of lot 3, part of lot 4 and part of lot 5 on plat of TRACT No. 8 JUDSON MILL PROPERTY recorded in the RMC Office Greenville County, S. C., in Plat Book " E " at Page 235 and also known as PROPERTY OF H. B. & FAY L. H. RIDDLE recorded in Plat Book " DD " at Page 115; and that the property lines, walls and buildings are as shown hereon, and that the walls and buildings located on said lot do not encroach or project on adjacent street or property, and that no adjacent walls or buildings encroach or project on said premises, and no power lines cross this property except as shown hereon.

6485

*R. B. Bruce*  
R. B. Bruce, RLS #1952

16-5-92

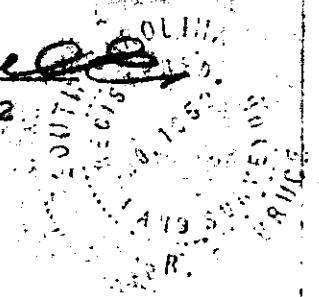

CAROLINA SURVEYING CO.  
112 W. Myrtle St.  
Greenville, S.C. 29601  
GCTO 2-AU28 78 1113

1.00CI