


MICROFILMED

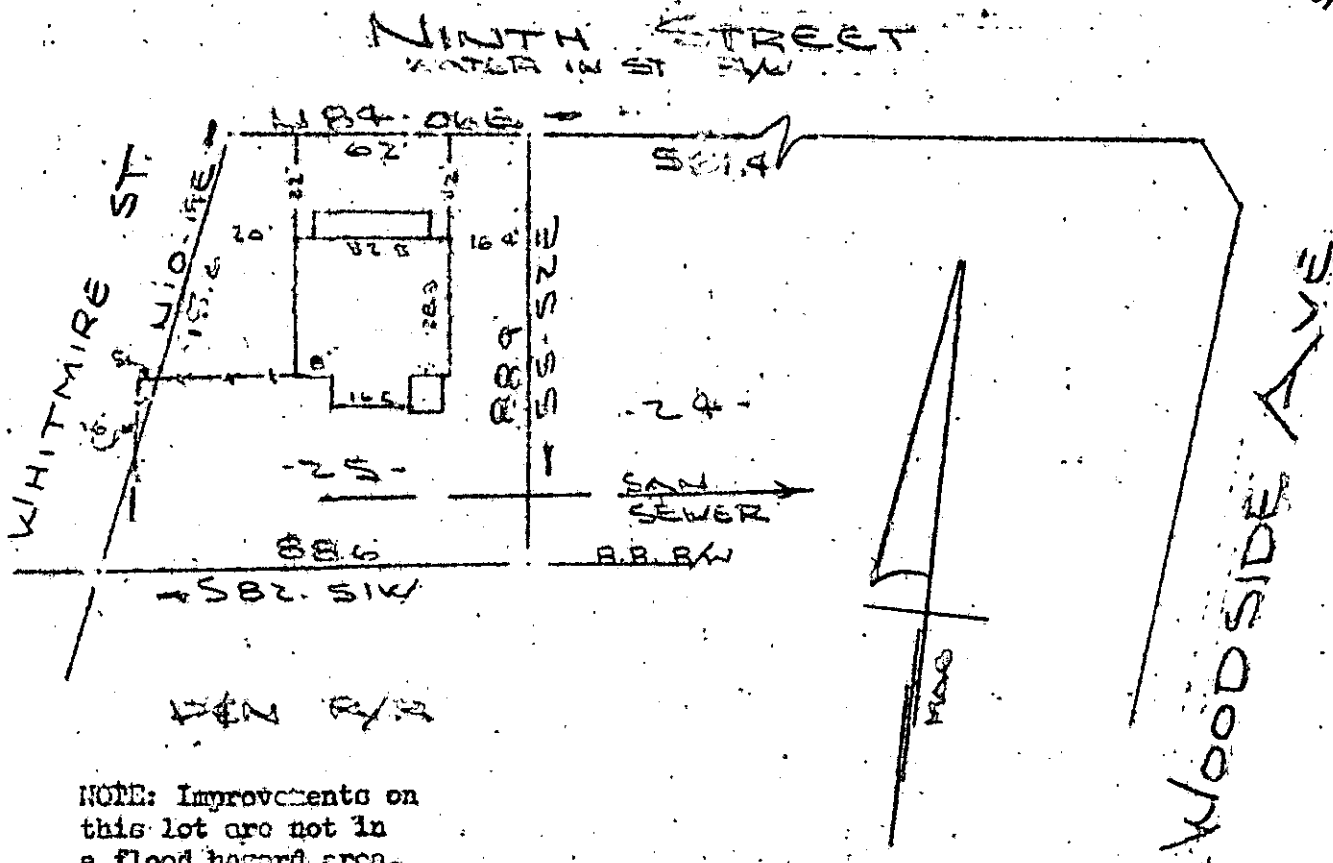

NOTE: Improvements on this lot are not in a flood hazard area.

SEP 1 2 45 PM '78
DONNIE S. TANKERSLEY
R.M.C.


GREENVILLE CO. S.C.

PROPERTY OF
ROBERT EARL HARVEY & KAREN T. HARVEY
 NEAR GREENVILLE, S.C.
 SCALE 1" = 40' 25 AUG 1978

This is to certify that on the 25th day of August, 1978, I surveyed the property shown hereon, being known as lot 25 on plat of ELECTION D WOODSIDE HILLS and recorded in the REC Office Greenville County, S. C., in Plat Book "W" at Pages 111 - 117; and that the property lines, walls and buildings are as shown hereon, and that the walls and buildings located on said lot do not encroach or project on adjacent street or property, and that no adjacent walls or buildings encroach or project on said premises, and no power lines cross this property except as shown hereon.

R. B. Bruce
 R. B. Bruce, REC #1952

16 T - 8 7149

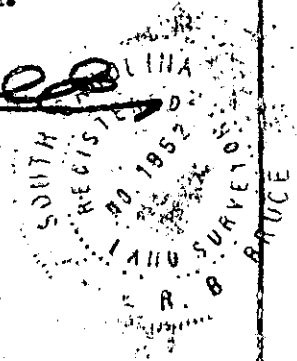

CAROLINA PRINTING CO.
 112 Main St.
 Greenville, S. C.

CGCTO --- 3 SE. 1 78 1076

1.00CI

208/222

126-9-10