FILED
GREENVILLE CO. S. C.
SEP 18 2 46 PM '78
DONNIE S. TANKERSLEY
R.M.C.

MICROFILMED

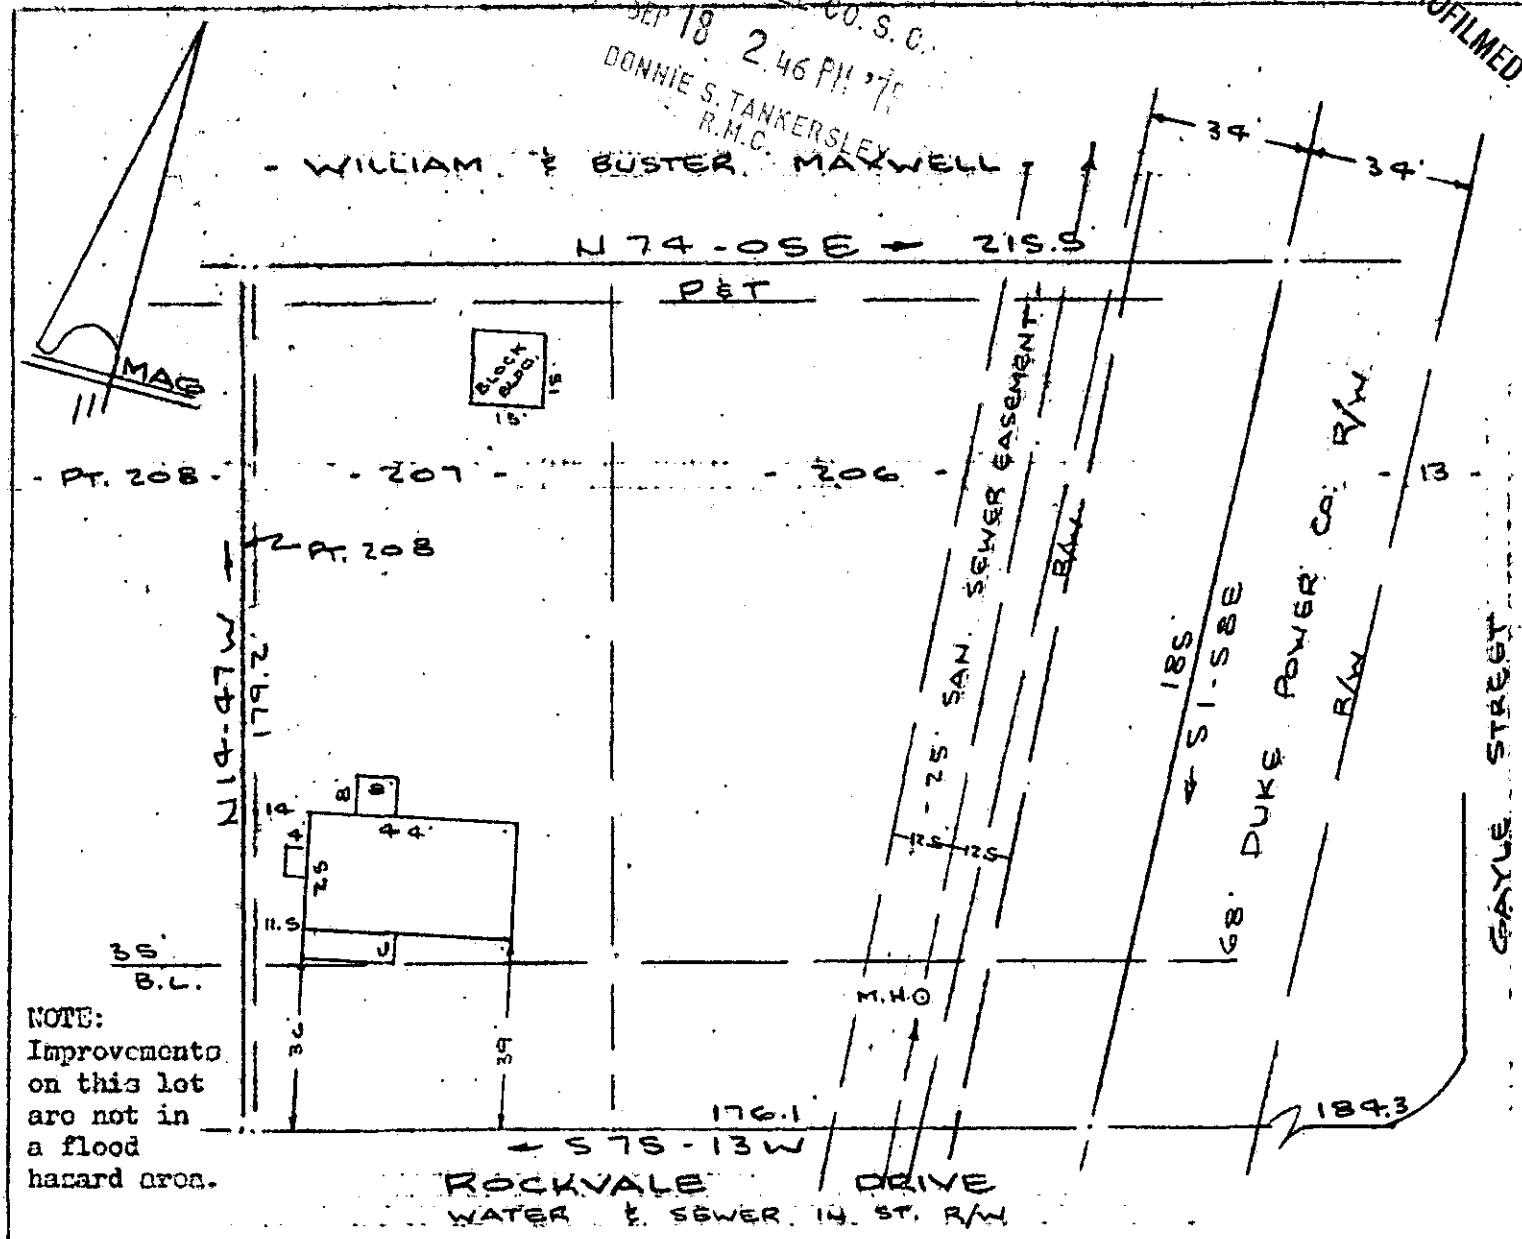


NOTE: Improvements on this lot are not in a flood hazard area.

PROPERTY OF

ARTHUR LEE MATHIS & MARIE J. FULLER

NEAR GREENVILLE, S. C.

SCALE: 1" = 40' 14 SEPT 1978

This is to certify that on the 14th day of September, 1978, I surveyed the property shown on this plat, being known as lot 206, lot 207 and part of lot 208 on plat of PROPERTY OF MARTIN R. KIMMONS & SHILIA ANN KIMMONS and recorded in the RMC Office Greenville County, S. C., in Plat Book " 4 - K " at Page 67; and that the property lines, walls and buildings are as shown hereon, and that the walls and buildings located on said lot do not encroach or project on adjacent street or property, and that no adjacent walls or buildins encroach or project on said premises, and no power lines cross this property except as shown hereon.

8689 6T-49

R. B. Bruce

R. B. Bruce, RLS #1952

SOUTH CAROLINA REGISTERED LAND SURVEYOR NO. 1952 R. B. BRUCE

SEP 18 1978

CAROLINA SURVEYING CO.
112 Manly St.
Greenville, S. C.

5 4 3 Sep 18E

1.00 A1

208/29

WG 6.2-1-254