


FILED
 GREENVILLE CO. S. C.
 NOV 3 3 59 PM '78
 DORRIS S. TAMMERSLEY
 R.M.C.

This is to certify that on November 2, 1978, I surveyed the property shown on this plat, known as Property of Mark E. Clifford and Margaret M. Clifford, recorded in the R.M.C. Office of Greenville County in Plat Book 6-0 or Page 32, and that the property lines walls and buildings are as show hereon, that the buildings located on said lot do not encroach or project on any adjacent streets or property, that no adjacent walls or buildings encroach or project on said premises, and that no utility lines cross this property except as shown hereon. These buildings are not located in a designated flood hazard area.

James R. Freeland
 James R. Freeland R.L.S. & P.E. 4781

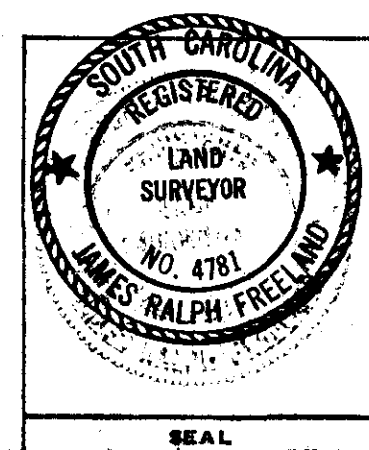

STATE OF SOUTH CAROLINA GREENVILLE COUNTY		FREELAND & ASSOCIATES Engineers • Land Surveyors GREENVILLE, S. C.
PROPERTY OF		SURVEY 13H & DG
MARK E CLIFFORD, MARGARET M CLIFFORD		DRAWN JRF
		CHECK JRF
		SCALE 1" = 100'
		DATE 11-2-78
		DWG. NO. 78-3907

T-35-1-19.4