


MICROFILMED

FILED
GREENVILLE CO. S. C.
JAN 8 4 31 PM '79
DONNIE S. TANKERSLEY
R.M.C.

NORTH MAIN ST

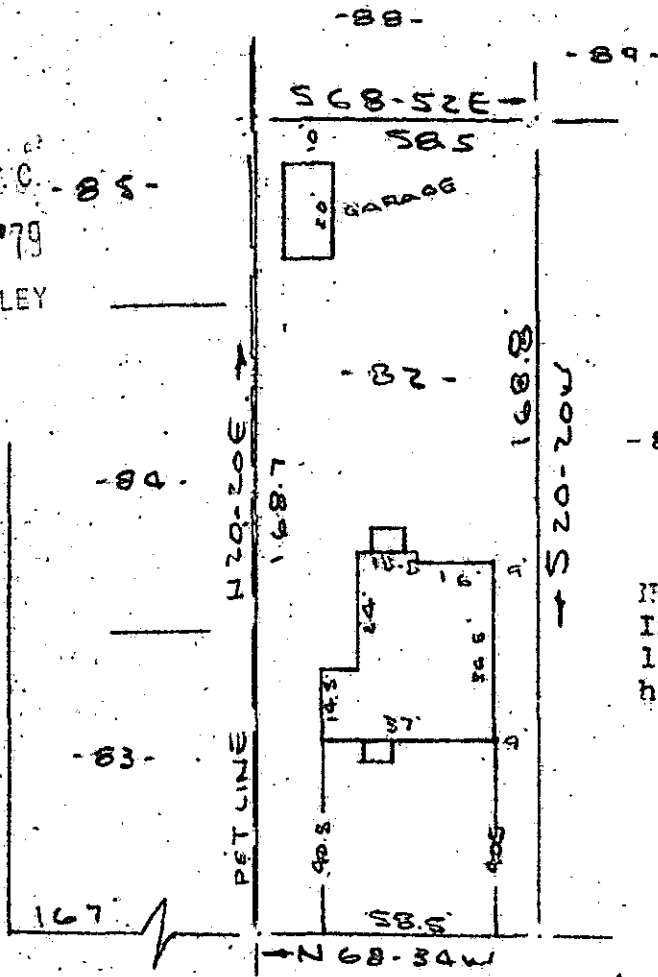

NOTE:
Improvements on this lot are not in a flood hazard area.

KENWOOD LANE
WATER & SEWER IN ST RW

(HESTON AVE)

JAN 8 1979

PROPERTY OF
THOMAS W BOYLE & SALLY R. BOYLE
GREENVILLE, S.C.
SCALE: 1" = 40'
2 JAN 1979

This is to certify that on the 2nd day of January, 1979, I surveyed the property shown on this plat, being known as lot 82 on plat of NORTH PARK and recorded in the RMC Office Greenville County, S. C., in Plat Book " K " at Pages 48 & 49; and that the property lines, walls and buildings are as shown hereon, and that the walls and buildings located on said lot do not encroach or project on adjacent street or property, and that no adjacent walls or buildings encroach or project on said premises, and no power lines cross this property except as shown hereon.

B. B. Bruce
R. B. Bruce, 085 1952



20221

CAROLINA SURVEYING CO.
112 Mainly St.
Greenville, S.C.

64-70 ✓

CGTC 1 JA 8 79 1122

1.0001

209/60

178-7-1F