MICROFILMED

FILED
GREENVILLE CO. S. C.
JAN 11 3 12 PM '79
DONNIE S. TANKERSLEY
R.M.C.

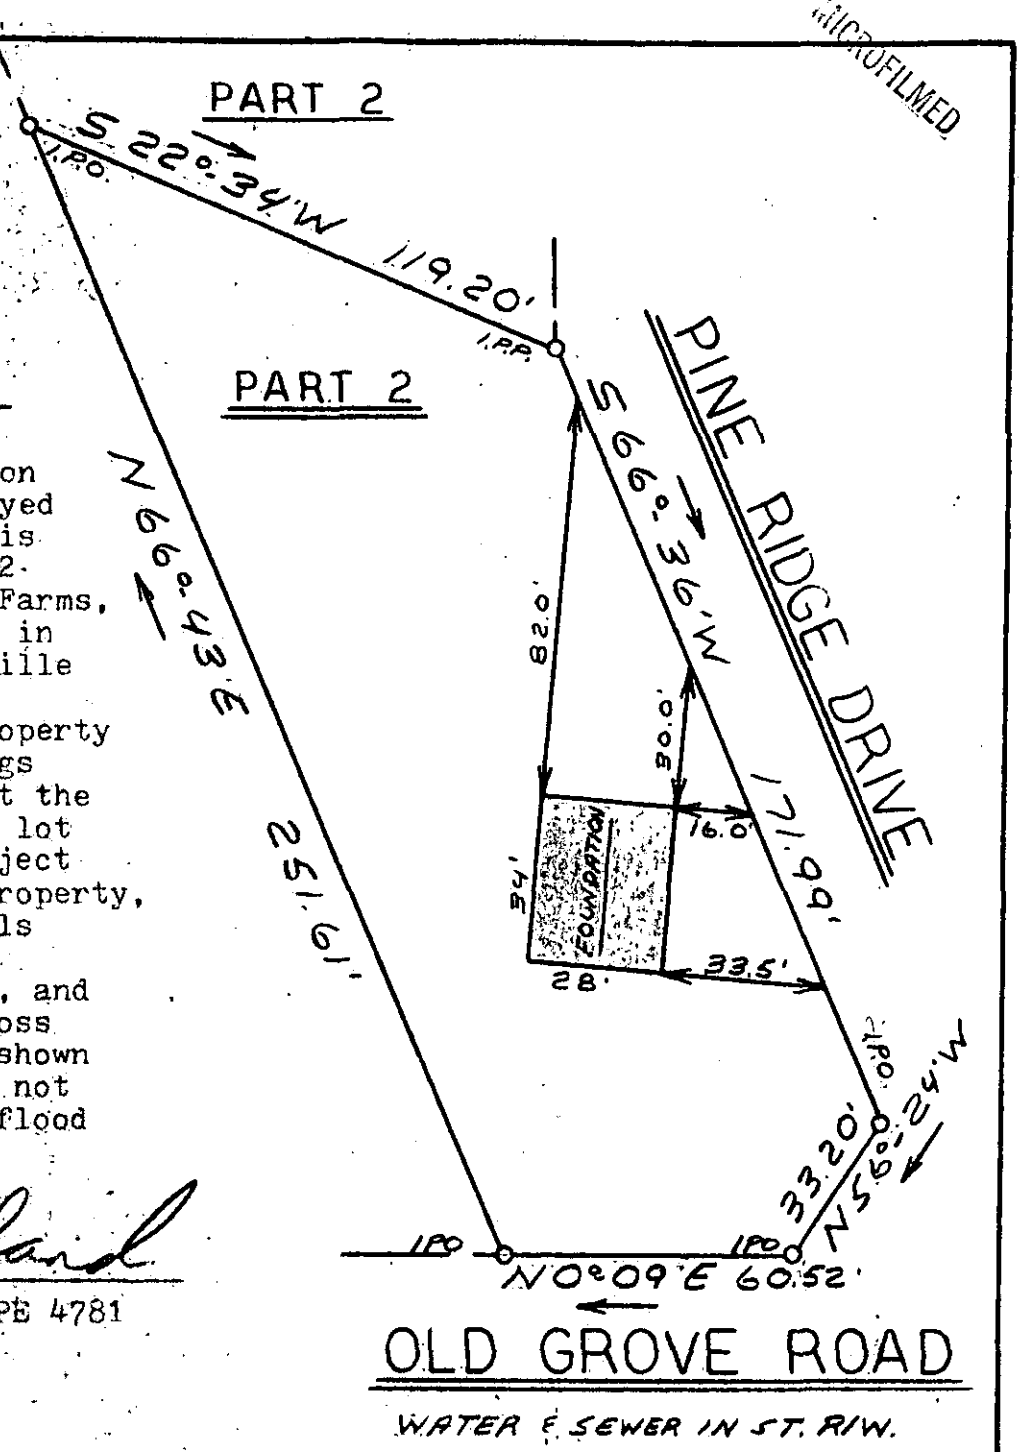

I

This is to certify that on January 5, 1979, I surveyed the property shown on this plat, known as Part Lot 2 on Plat of Fresh Meadow Farms, Plat 1, Sec. 2, recorded in the RMC Office of Greenville County in Plat Book S on Page 61, and that the property lines, walls and buildings aregas shown hereon; that the building located on said lot does not encroach or project on adjacent streets or property, and that no adjacent walls or buildings encroach or project on said premises, and that no utility lines cross this property except as shown hereon. This property is not located in a designated flood hazard area.

James R. Freeland

James R. Freeland RLS & PE 4781

6-Y-85

20618

WG 1.2-2-9

SOUTH CAROLINA REGISTERED LAND SURVEYOR NO. 4781 JAMES RALPH FREELAND

SEAL

STATE OF SOUTH CAROLINA
GREENVILLE COUNTY

FRESH MEADOW FARMS

SEC. 2 - PART LOT 2

PROPERTY OF

ROBERT JOE GAINES

FREELAND & ASSOCIATES
Engineers • Land Surveyors
GREENVILLE, S. C.

SURVEY	MC
DRAWN	MC
CHECK	WBM
SCALE	1"=40'
DATE	1-5-79
DWG. NO.	79-2760

GCTO ----- 2 JAN 79 1567