



MICROFILMED

FILED
GREENVILLE CO. S.C.
MAR 13 1 06 PM '79
DONNIE S. TANKERSLEY
R.M.C.

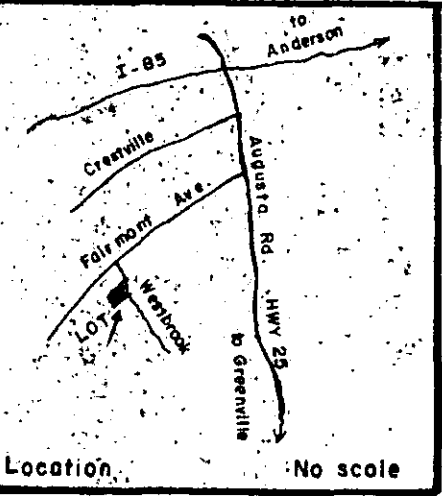

FAIRMONT AVENUE

WESTBROOK LANE

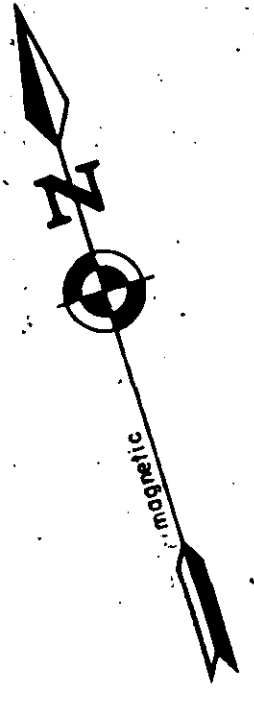

(16)

(14)

(15)

(17)

(19)

(20)

Loan Survey

State of South Carolina
County of Greenville

Brookforest Subdivision
22 Westbrook Lane
Located near Greenville

Being designated as lot 15 on a Plat recorded in Plat book LL, page 188
entitled Revision Lots 13-14-15, Block C, Brookforest, Near Greenville, S. C., Tax Map 380-5-8

Surveyed March 1, 1979 at the request of Stephen L. and Linda D. Keener

This is to certify that the measurements as shown above are correct and that there are no
encroachments or projections other than shown.

Above Flood plane.



R.D. Garrison

7-A-16

26156

ANDERSON SURVEYING ASSOCIATES, INC.
P. O. BOX 784 · PHONE 226-7813
709 S. MAIN STREET
ANDERSON, SOUTH CAROLINA 29621



I.O. - Iron pin, old
I.N. - Iron pin, new

GCTO -----3 MR13 79 245