MICROFILMED

FILED
GREENVILLE CO. S. C.
MAY 2 3 08 PM '79
DONNIE S. TANKERSLEY
R.M.C.

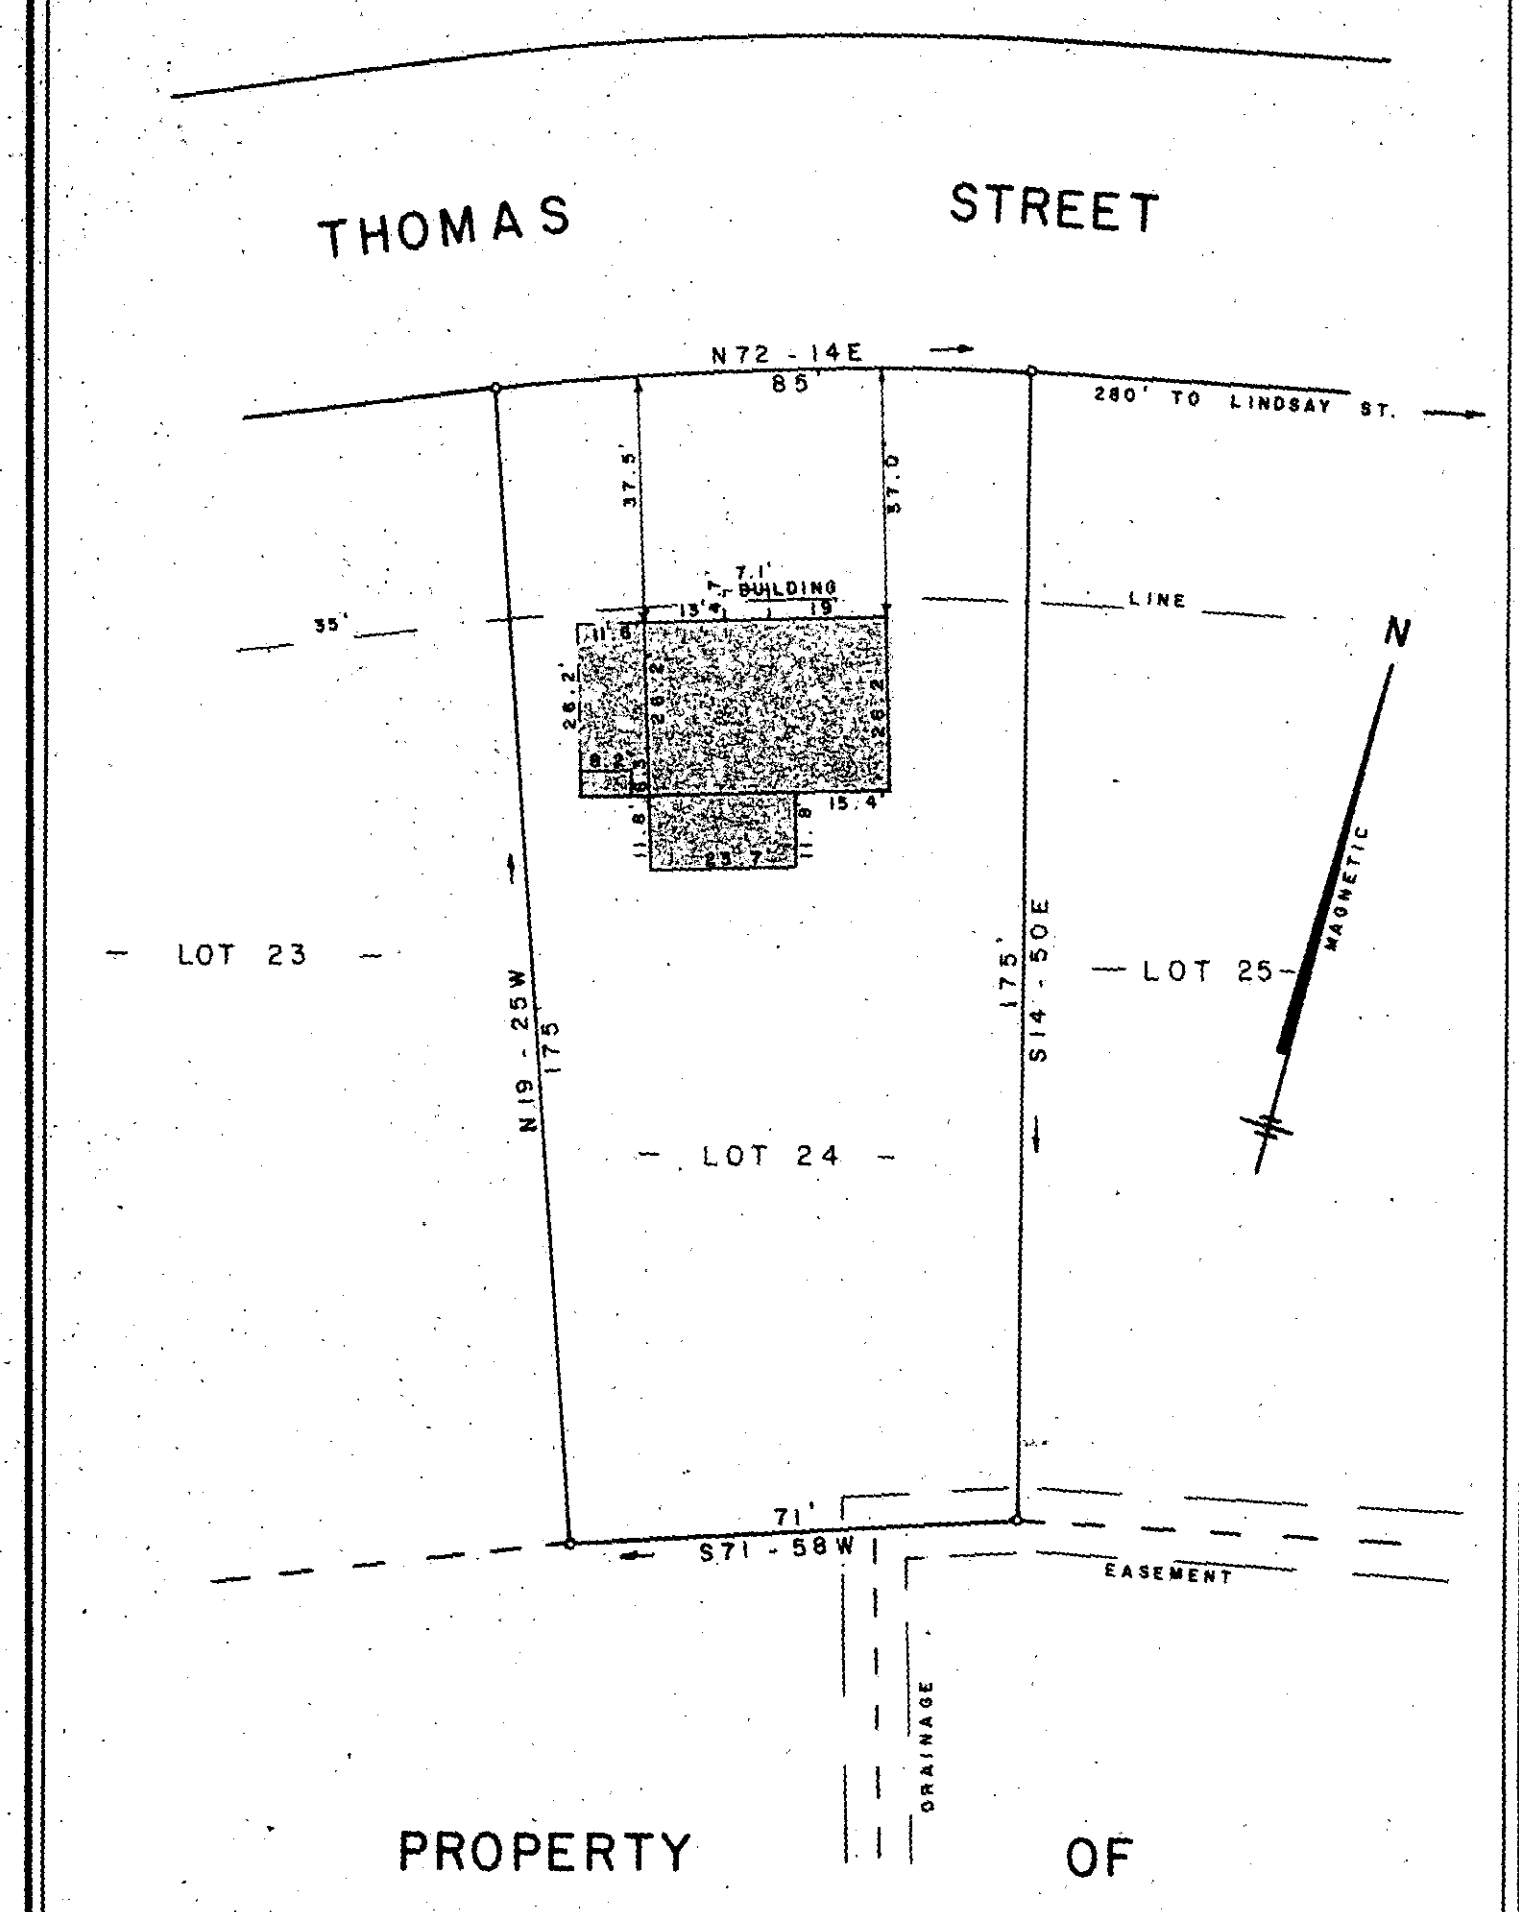

PROPERTY OF

RONALD ANTHONY ENGEL
TAMELA DENISE HAMILTON

NEAR GREENVILLE — GREENVILLE CO.

SOUTH CAROLINA

APRIL 13, 1979

✓ 7-A-59

31982

MAY 2 1979

GCTO — 3 MY 2 79 289

This is to certify that on the 20th day of April, 1979, I surveyed the property shown on this plat; being the same property shown as Lot 24, Monaghan Subdivision, recorded in R.M.C. for Greenville County in Plat Book GG, Page 87, and that the property lines, walks and buildings are as shown hereon; that the buildings located on said property do not encroach or project on adjacent streets or property except as shown hereon; and that no adjacent buildings or walls encroach or project on said premises. The structures located on this property are not located in an area designated as a flood plain.

W. R. WILLIAMS, JR. ENGR./SURVEYOR #3979
151 SOUTH MAIN STREET
TRAVELERS REST, S.C.

F.B. 32 143 - 4 - 9

SCALE 1" = 30'