

MICROFILMED

GREENVILLE, CO. S. C.


MAR 30 3 10 PM '79

DONNIE S. TANKERSLEY  
R.M.C.

MAR 30 1979

COOL BROOK DR

FLEETWOOD DR.  
W/S IN STREET R/W

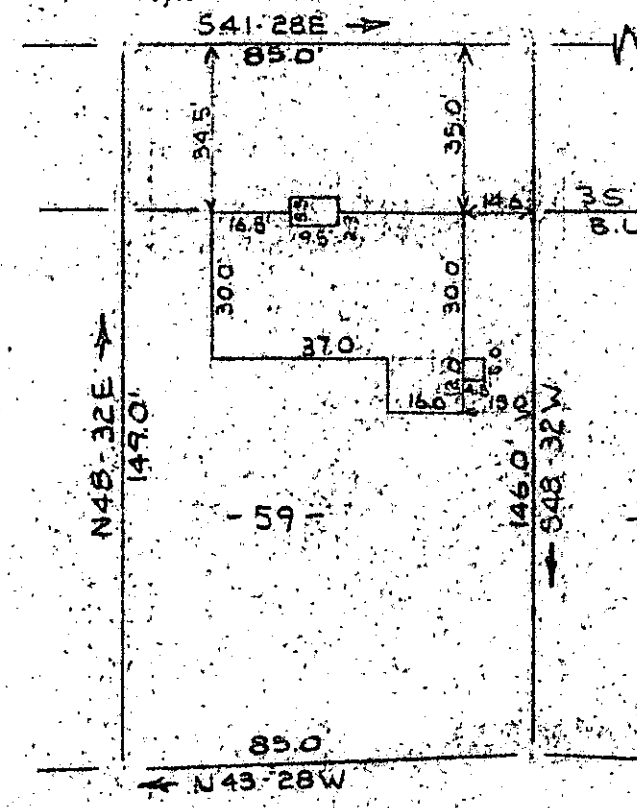

NOTE:

Improvements on this lot are not in a flood hazard area.

-60-

-59-

-58-

-63-

-64-

PROPERTY OF  
PAUL MIMS, Sr. & NANNIE MAE MIMS  
NEAR GREENVILLE, S.C.  
SCALE: 1"=40' 7MARCH79

This is to certify that on the 7th day of March, 1979, I surveyed the property shown on this plat, being known as lot 59 on plat of MAGNOLIA ACRES and recorded in the RMC Office Greenville County, S. C., in Plat Book "GG" at Page 133; and that the property lines, walls and buildings are as shown hereon, and that the walls and buildings located on said lot do not encroach or project on adjacent street or property, and that no adjacent walls or buildings encroach or project on said premises, and no power lines cross this property except as shown hereon.

28220 17-D-11

CAROLINA SURVEYING CO.  
112 Manly St.  
Greenville, S. C.

R. B. Bruce

R. B. Bruce, RLS #1952

GCTO --- 1 MR30 79 1246

1.000CI

208/79

389-3-8

12367