
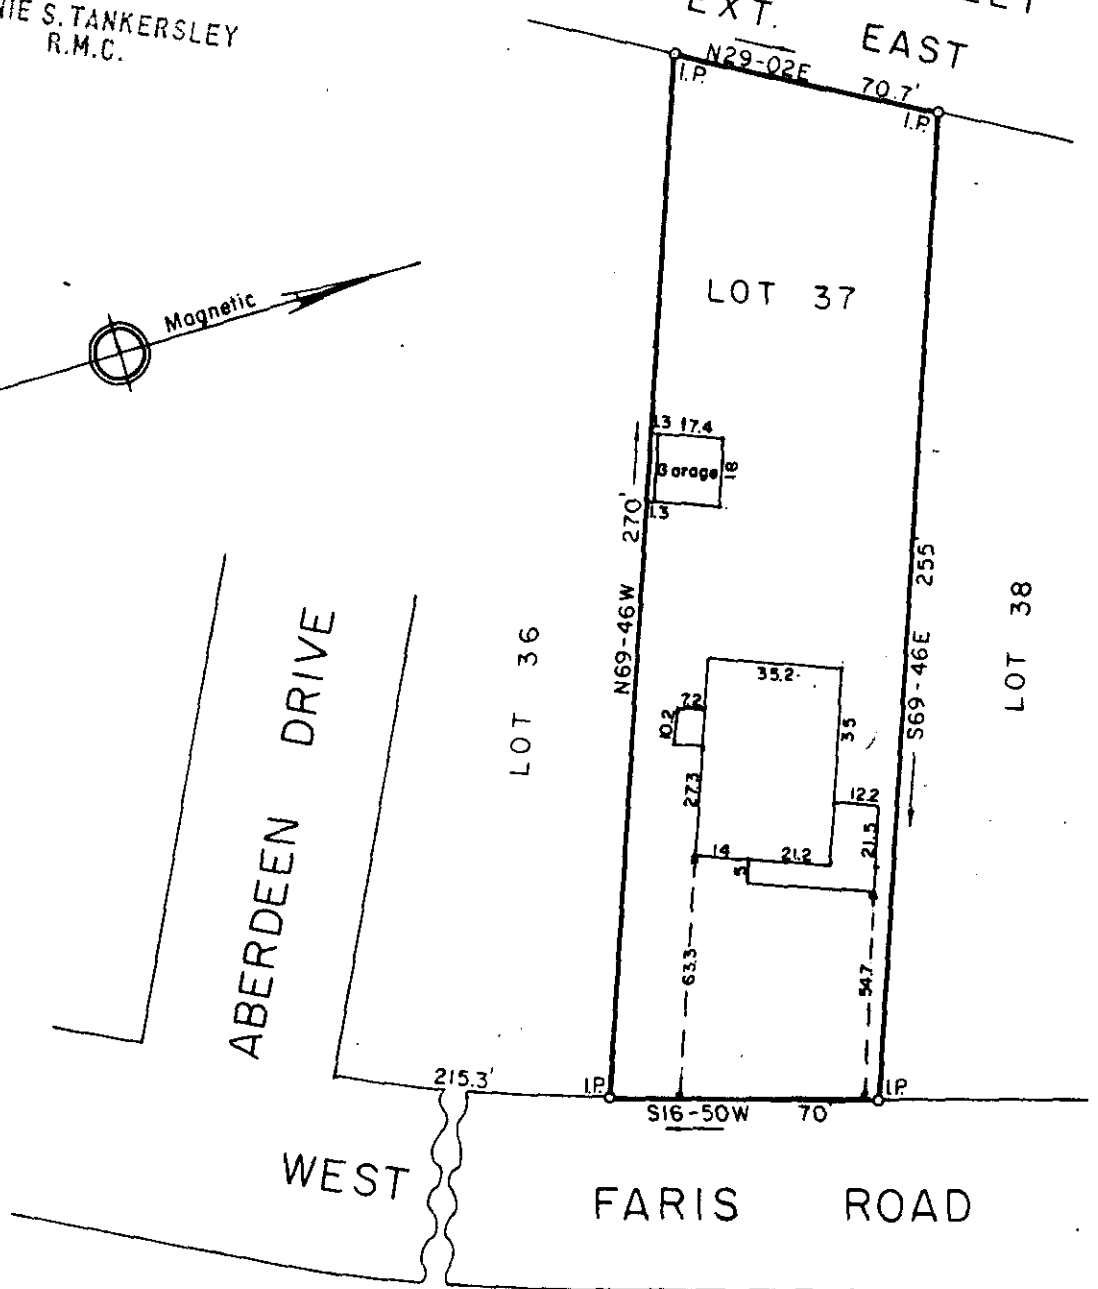


MICROFILMED

FILED  
GREENVILLE, CO. S. C.  
APR 12 10 53 AM '79  
DONNIE S. TANKERSLEY  
R.M.C.

SEVIER STREET  
EXT. EAST

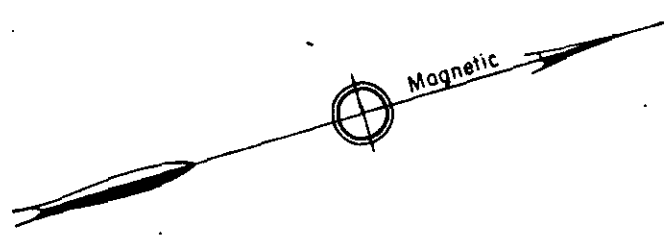

PROPERTY OF  
BOYD L. MURPHY  
CHRISTINA B. MURPHY  
GREENVILLE COUNTY  
GREENVILLE, SOUTH CAROLINA

Scale 1" = 50' March, 1979

DALTON & NEVES CO., ENGINEERS  
121 MANLY STREET  
GREENVILLE, S. C.

APR 12 1979

29712 ✓

7-D-53



*William B. Fant*  
W. B. Fant

F. B. 438  
S. C. Reg. No. 6266

GETO 3 AP 12 79 1521

1.00CI