


MICROFILMED

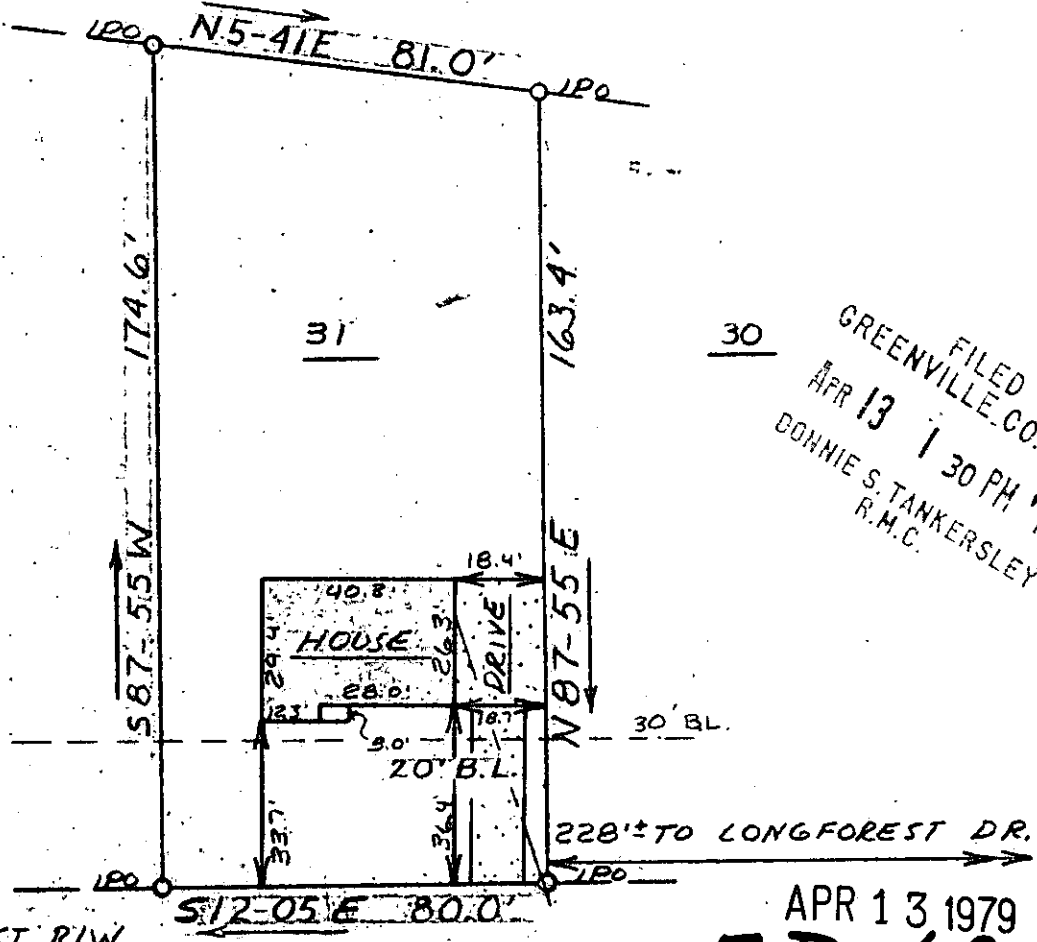

FILED
 GREENVILLE CO. S. C.
 APR 13 1 30 PM '79
 BONNIE S. TANKERSLEY
 R.M.C.

APR 13 1979
 7D-62 ✓

WATER & SEWER IN ST. R/W

BLACKSTONE DRIVE

This is to certify that on April 11, 1979, I surveyed the property shown on this plat known as Lot 31, on Plat of New Furman Heights recorded in the RMC Office of Greenville County in Plat Book EE on Page 75A, and that the property lines, walls, and buildings are as shown hereon; that the building located on said lot does not encroach or project on adjacent streets or property, and that no adjacent walls or buildings encroach or project on said premises, and that no utility lines cross this property except as shown hereon. This property is not located in a designated flood hazard area.

29816 *James R. Freeland*
 James R. Freeland RLS & PE 4781

APR 13 1979

424-1-4



STATE OF SOUTH CAROLINA
GREENVILLE COUNTY

NEW FURMAN HEIGHTS
 PROPERTY OF
 PHILLIP T. MONTEITH &
 VICKIE J. MONTEITH
 LOT 31

FREELAND & ASSOCIATES
 Engineers • Land Surveyors

GREENVILLE, S. C.

SURVEY	D.H.
DRAWN	JMB
CHECK	WBA
SCALE	1" = 40'
DATE	4-11-79
DWG. NO.	79-3170

8 2 1 7 7 9 7 2 E

1 0 0 M

SEAL