


MICROFILMED

APR 23 11:50 AM '79
263
DONNIE S. TANKERSLEY
R.H.C.

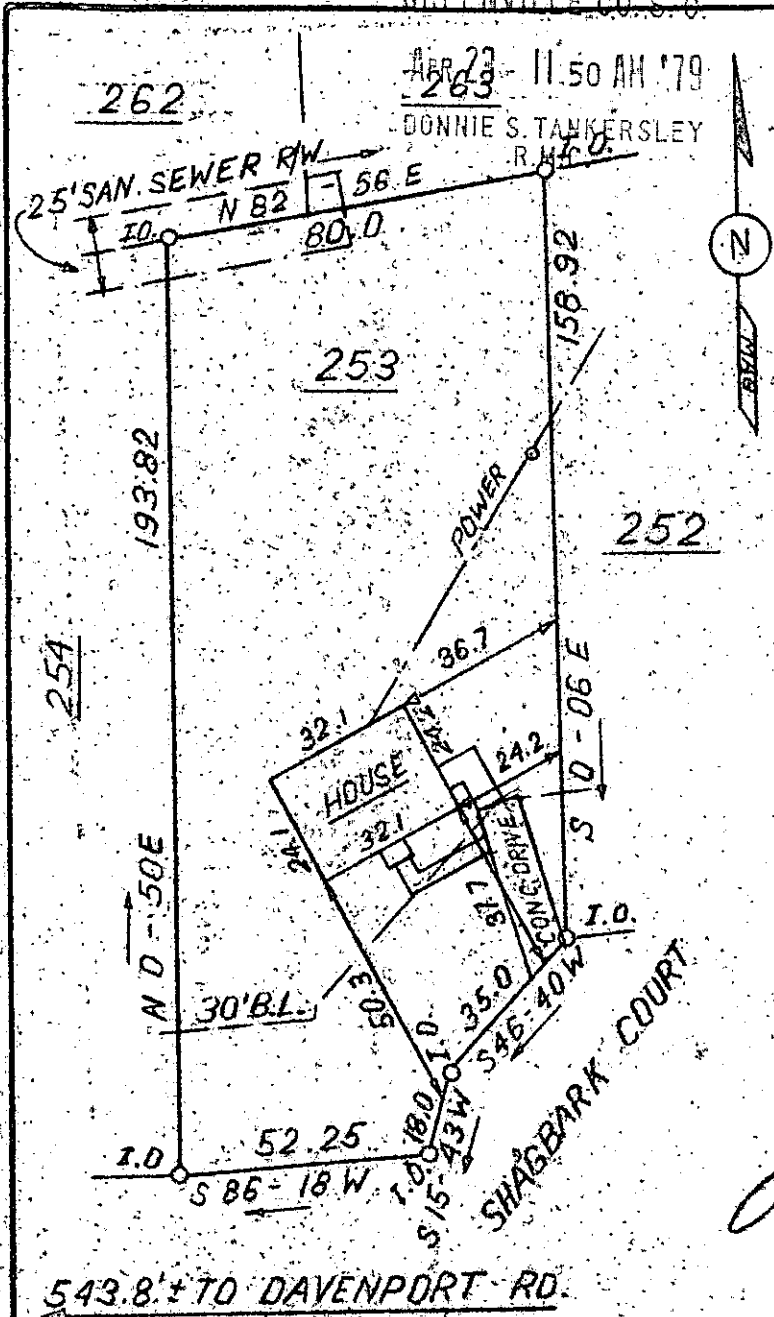

This is to certify that on April 18, 1979, I surveyed the property shown on this plat, known as Lot 253 on Plat of Westwood South, Sec. 1, recorded in the RMC Office of Greenville County in Plat Book 6 H on Page 57, and that the property lines, walls and buildings are as shown hereon; that the building located on said lot does not encroach or project on adjacent streets or property, and that no adjacent walls or buildings encroach or project on said premises, and that no utility lines cross this property except as shown hereon. This property is not located in a designated flood hazard area.

James R. Freeland
James R. Freeland RLS & PE 4781


543.8' ± TO DAVENPORT RD.

WATER & SEWER IN ST. R/W

5' drainage & utility easement each side of all side & rear lot lines.

7-D-92

30846

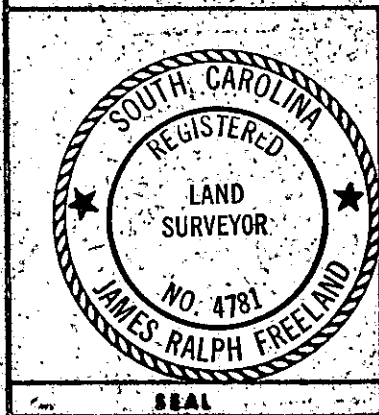

**STATE OF SOUTH CAROLINA
GREENVILLE COUNTY**

WESTWOOD SOUTH
LOT 253 SEC 1
PROPERTY OF
JAMES R. HENDERSON
DONNA M. HENDERSON

FREELAND & ASSOCIATES
Engineers • Land Surveyors

GREENVILLE, S. C.

SURVEY	D.H.
DRAWN	B.R.
CHECK	M.C.
SCALE	1" = 40'
DATE	APRIL 19, 79
DWG. NO.	79-3218