


MICROFILMED

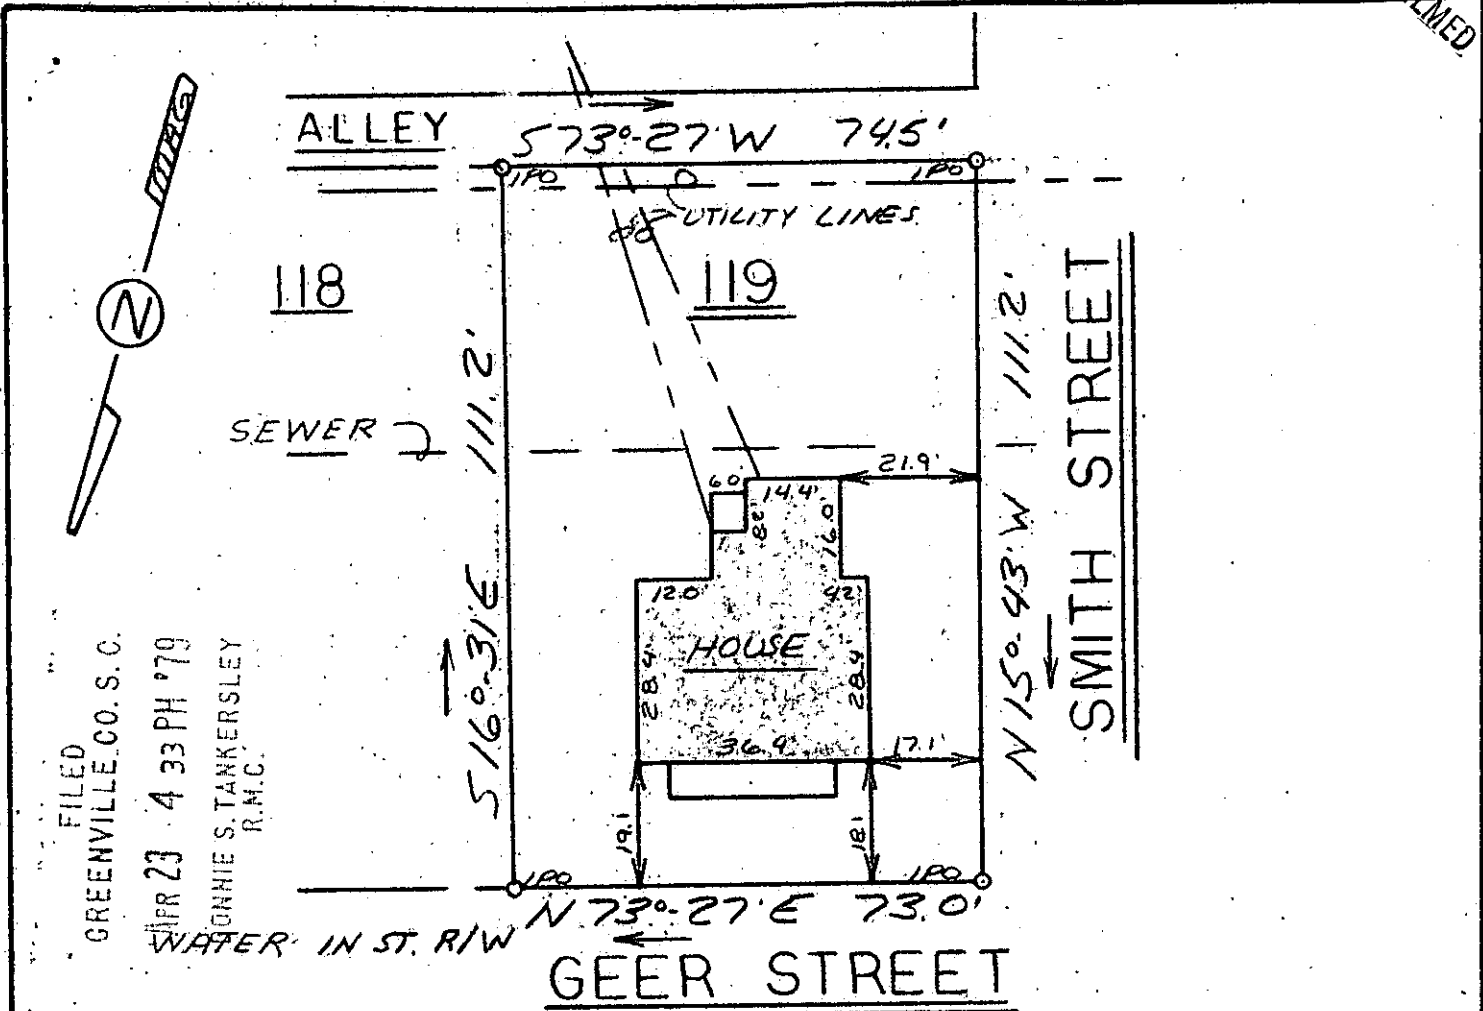

FILED
GREENVILLE, CO. S. C.
APR 23 4 33 PM '79
RONNIE S. TANKERSLEY
R.M.C.

This is to certify that on March 21, 1979, I surveyed the property shown on this plat known as Lot 119 on Plat of Greer Mill Village recorded in the RMC Office of Greenville County in Plat Book Y on Page 138 & 139, and that the property lines, walls, and buildings are as shown hereon; that the building located on said lot does not encroach or project on adjacent streets or property, and that no adjacent walls or buildings encroach or project on said premises, and that no utility lines cross this property except as shown hereon. This property is not located in a designated flood hazard area.

30842

James R. Freeland
James R. Freeland RLS & PE 4781

7-D-96



**STATE OF SOUTH CAROLINA
GREENVILLE COUNTY**

FREELAND & ASSOCIATES
Engineers • Land Surveyors

GREER MILL VILLAGE

GREENVILLE, S. C.

LOT 119

PROPERTY OF

Ronald W. Brown
RONALD W. BROWN

SURVEY	D.H.
DRAWN	M.C.
CHECK	J.R.
SCALE	1" = 30'
DATE	3-21-79
DWG. NO.	79-3070

892

SEAL