



MICROFILMED

FILED
GREENVILLE CO. S. C.

APR 25 1 54 PM '79

DONNIE S. TANKERSLEY
R.M.C.

STONE

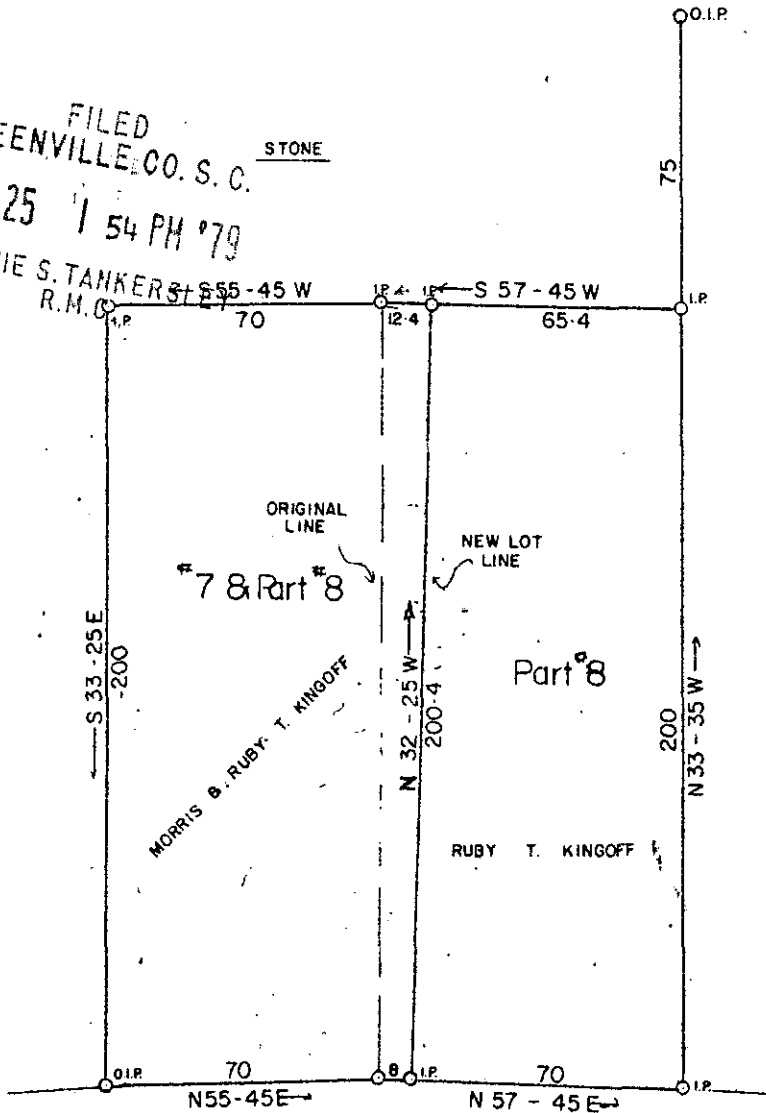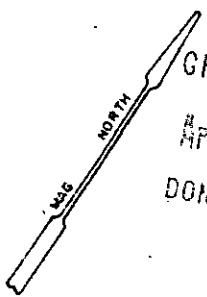



WEDGEWOOD DRIVE

31106

NOTE: REVISION OF LOTS 7 & 8
BLOCK 183-2-2 7 & 8

PROPERTY OF
MORRIS KINGOFF
RUBY T. KINGOFF
GREENVILLE S. C.

SCALE 1" = 50' APRIL - 17 - 79

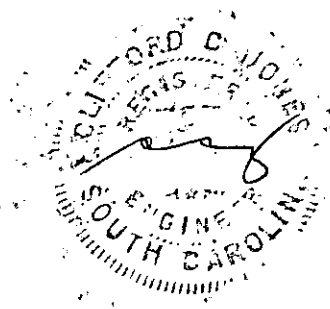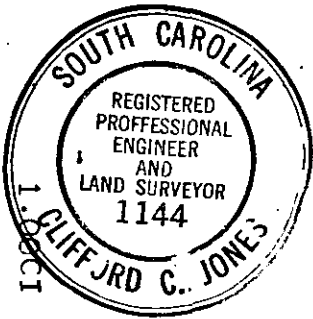

7-E-4

GCTO --- 1 AP 25 79 133