MICROFILMED

FILED
GREENVILLE CO. S. C.
MAY 1 12 51 PM '79
DONNIE S. TANKERSLEY
R.M.C.

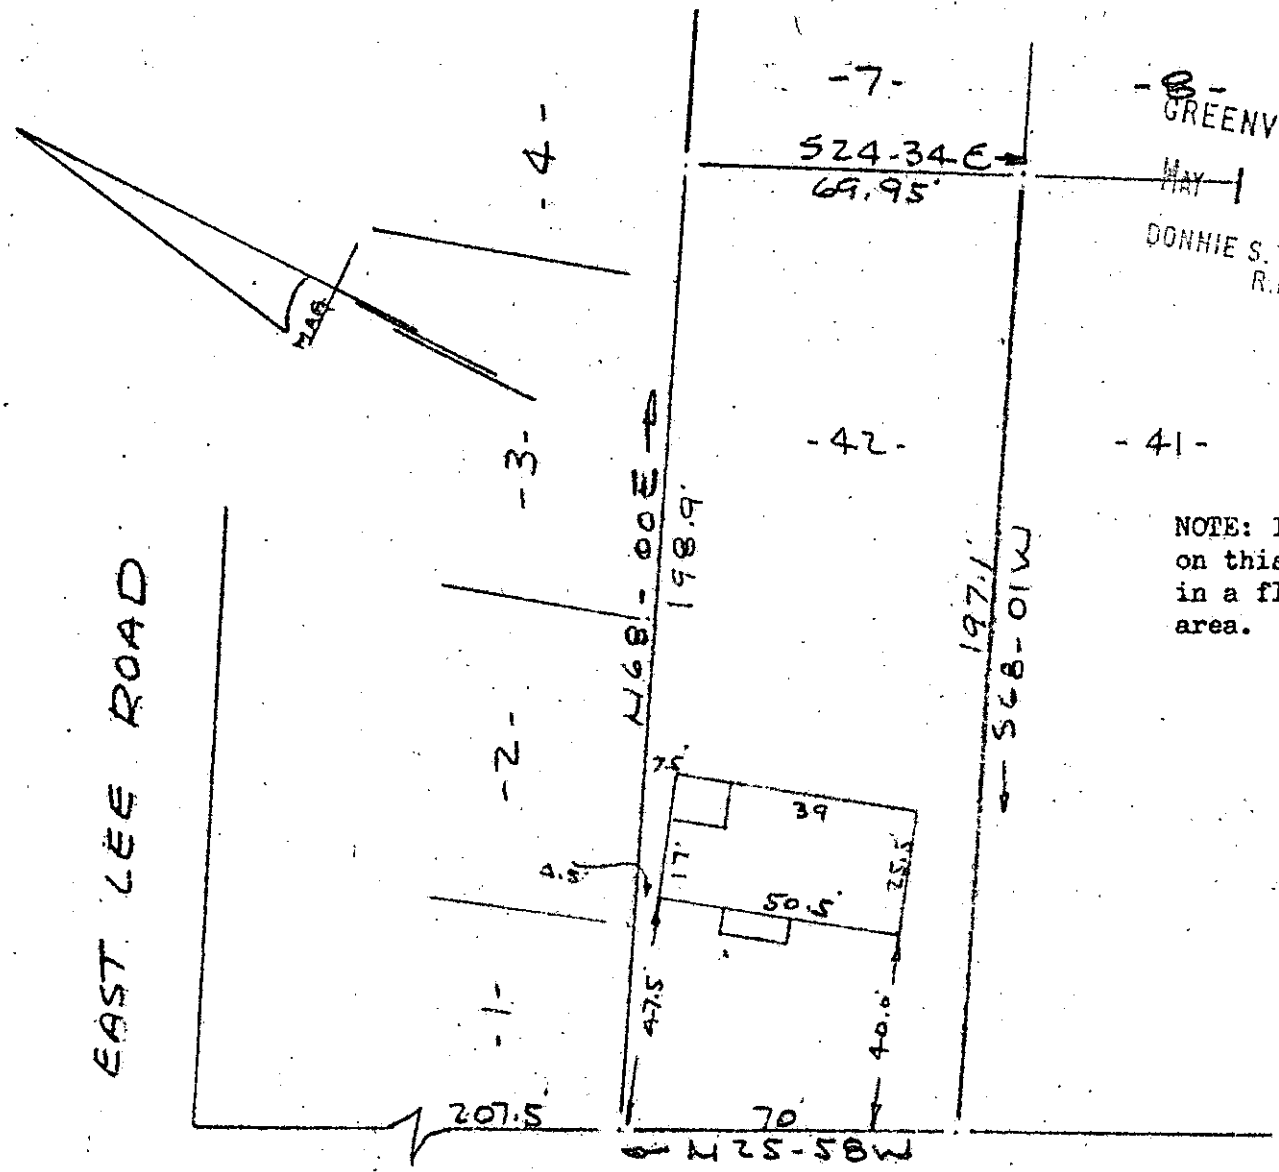

NOTE: Improvements on this lot are not in a flood hazard area.

PROPERTY OF
TIMOTHY T. McQUEEN & ALICIA H. McQUEEN
NEAR GREENVILLE, S.C.
SCALE 1" = 40 18 APRIL 1979

This is to certify that on the 18th day of April, 1979, I surveyed the property shown on this plat, being known as lot 42 on plat of CARDINAL PARK and recorded in the RMC Office Greenville County, S. C., in Plat Book " W " at Page 27; and that the property lines, walls and buildings are as shown hereon, and that the walls and buildings located on said lot do not encroach or project on adjacent street or property, and that no adjacent walls or buildings encroach or project on said premises, and no power lines cross this property except as shown hereon.

MAY 1 1979 31806

✓7-E-26

R. B. Bruce

R. B. Bruce, RLS #1952

CAROLINA SURVEYING CO.
112 Manly St.
Greenville, S. C.

6CTO MY 1 79 785
1.00CI