


CRESCENT AVENUE

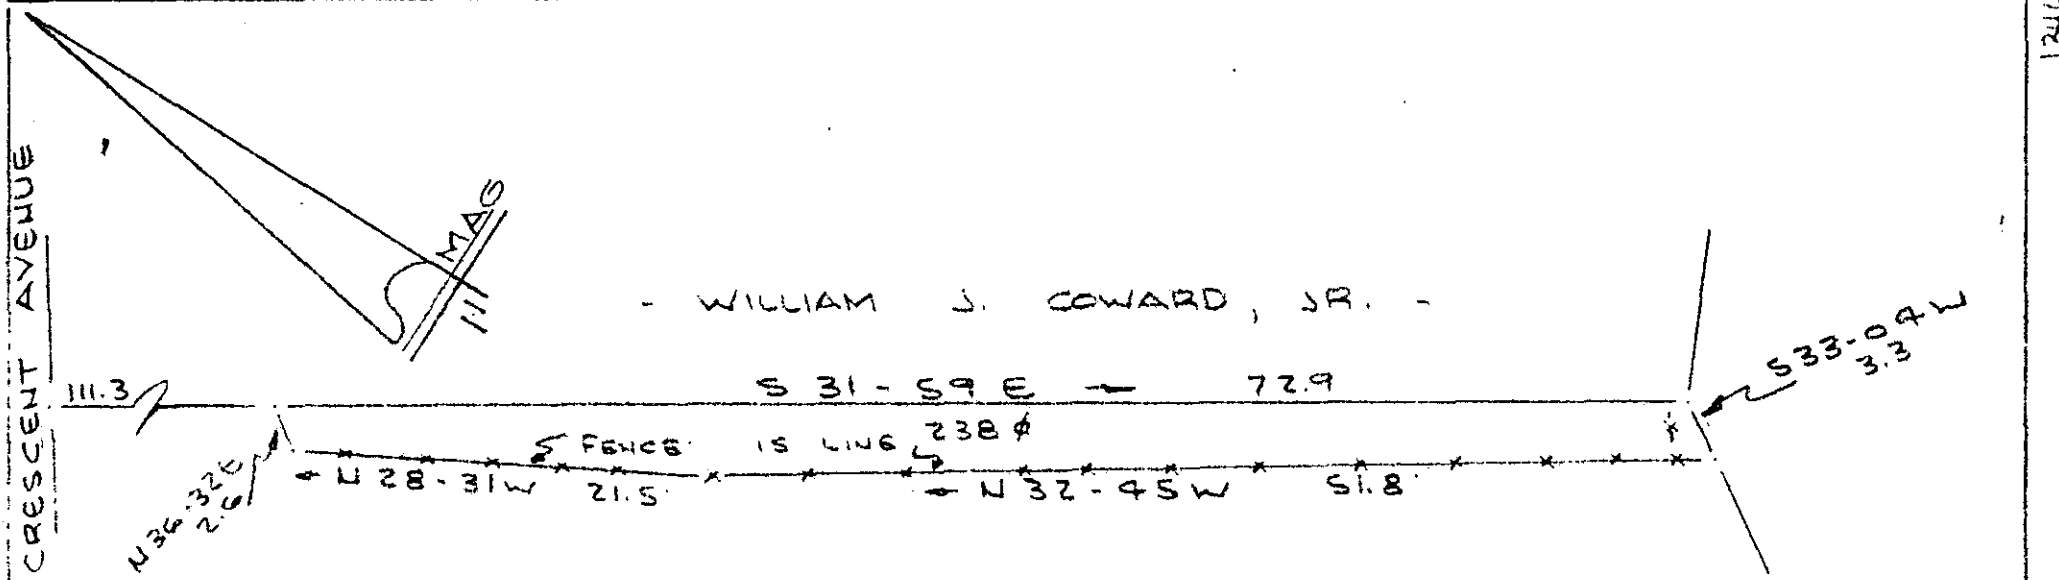

- WILLIAM J. COWARD, JR. -

- CHRIST CHURCH - JEAN R. MEKISSICK LIFE EST. -

SURVEY FOR
 WILLIAM J. COWARD, JR.
 GREENVILLE, SOUTH CAROLINA
 SCALE: 1" = 10' 23 MAR 1979

FILED
 GREENVILLE CO. S. C.
 MAY 3 12 33 PM '79
 DONNIE S. TANKERSLEY
 R.M.C.

32109 ✓ 7-E-36

MAY 3 1979

CAROLINA SURVEYING Co

112 MANLY GOSTE-----2 MY. 379 1129
 GREENVILLE, S. C.

R. B. Brubaker #1952
 10001

MICROFILMED