


MICROFILMED

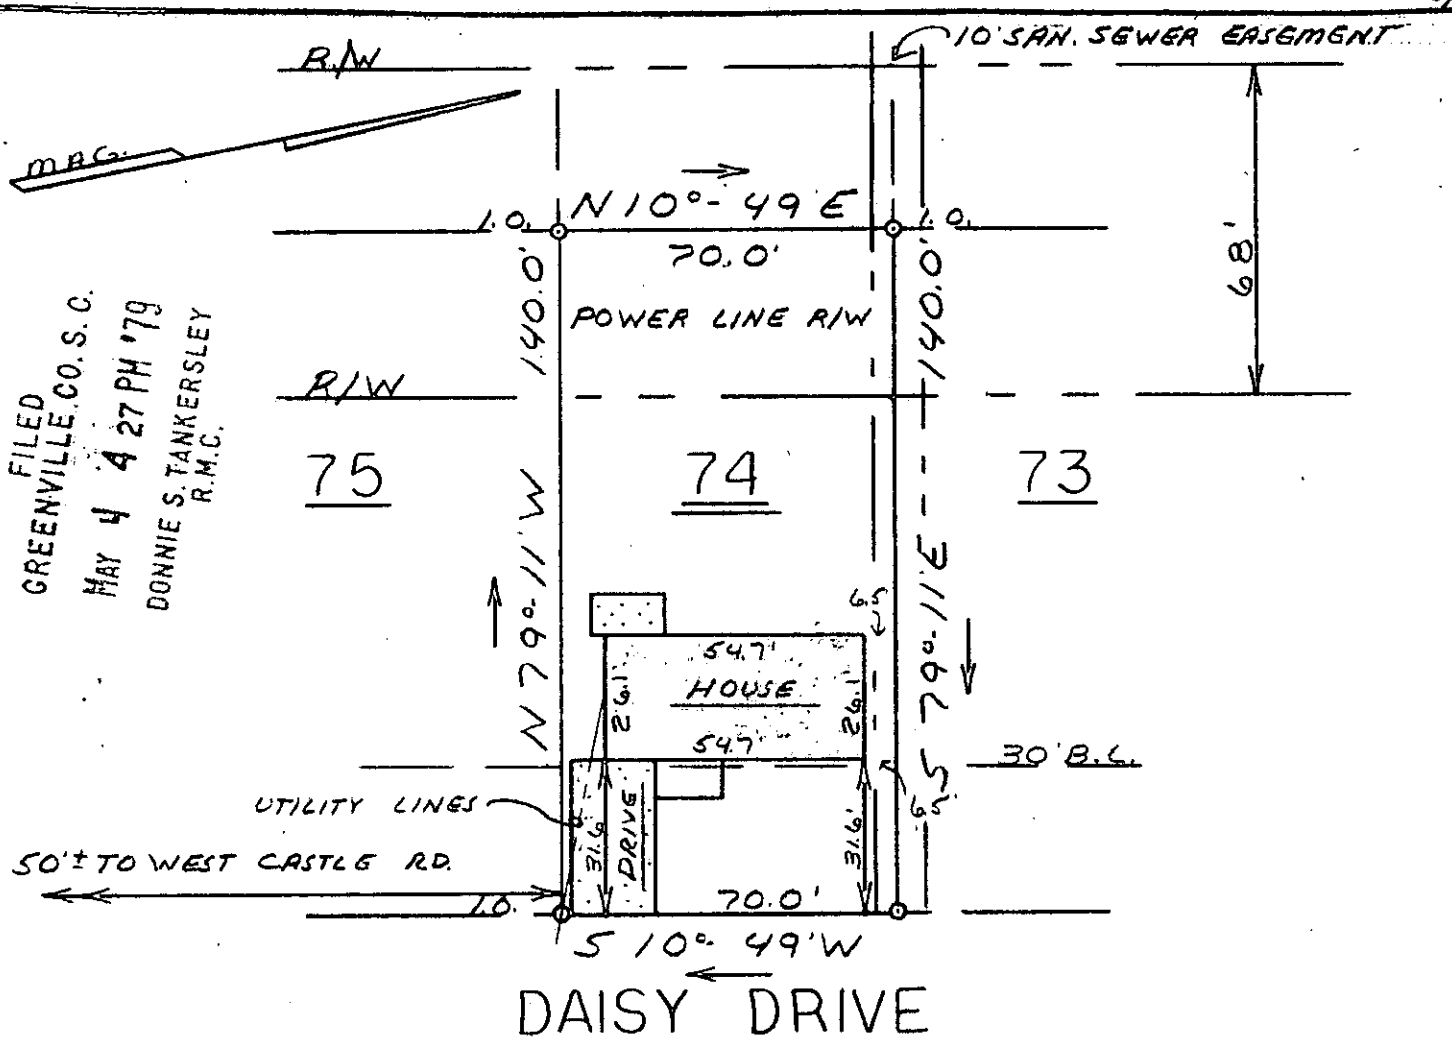

FILED  
 GREENVILLE, CO. S. C.  
 MAY 4 4 27 PM '79  
 DONNIE S. TANKERSLEY  
 R.M.C.

This is to certify that on May 3, 1979, I surveyed the property shown on this plat, known as Lot 74 on Plat of Pine Hill Village, recorded in the REC Office of Greenville County in Plat Book QQ on Page 169, and that the property lines, walls and buildings are as shown hereon; that the building located on said lot does not encroach or project on adjacent streets or property, and that no adjacent walls or buildings encroach or project on said premises, and that no utility lines cross this property except as shown hereon. This property is not located in a designated flood hazard area.

drainage & utility easement  
 each side of all side & rear  
 lot lines.

*James R. Freeland*  
 James R. Freeland RLS & PE 4781

MAY 4 1979 7-E-45 32265



STATE OF SOUTH CAROLINA  
 GREENVILLE COUNTY

PINE HILL VILLAGE

LOT 74  
 PROPERTY OF  
 JOSEPH E. BECK &  
 ELEANOR T. BECK

FREELAND & ASSOCIATES  
 Engineers • Land Surveyors  
 GREENVILLE, S. C.

SURVEY	M. C.
DRAWN	M. C.
CHECK	MC
SCALE	1" = 40'
DATE	5-3-79
DWG. NO.	79-3297

588  
 1.0001