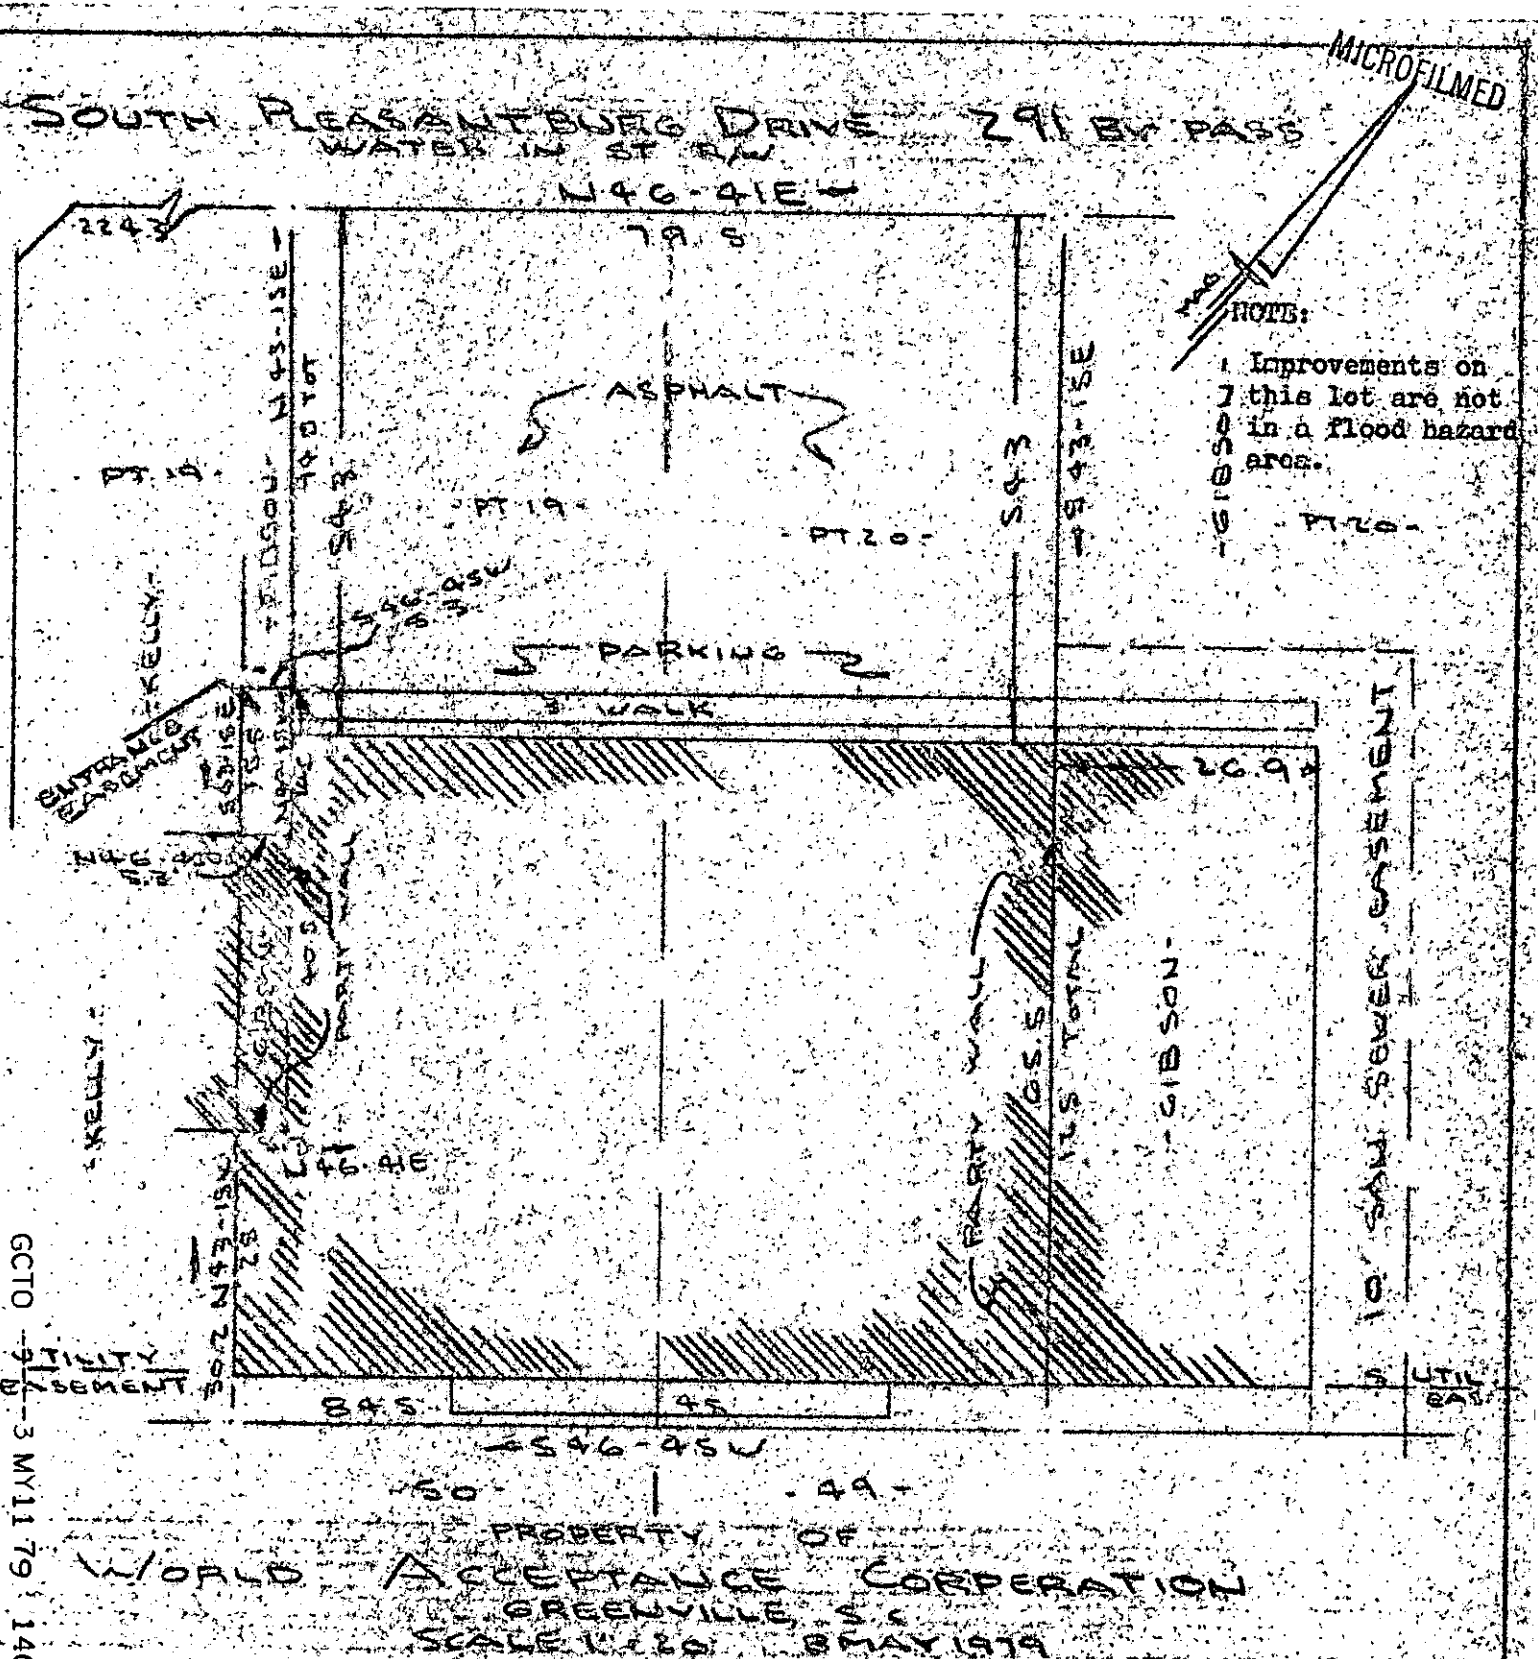

This is to certify that on the 8th day of May, 1979, I surveyed the property shown on this plat, being known as a portion of lots 19 & 20 on plat of PARAMOUNT PARK and recorded in the RMC Office Greenville County, S.C., in Plat Book " W " at Page 57; and that the property lines, walls and buildings are as shown hereon, and that the walls and buildings located on said lot do not encroach or project on adjacent street or property, and that no adjacent walls or buildings encroach or project on said premises, and no power lines cross this property except as shown hereon.

32967

11-8-79

CAROLINA SURVEY COMPANY
112 Manly Street
Greenville, S.C.

R.B. Bruce, RLS #1952

GCTO 1.00CI

MAY 11 12 03 PM '79
DONNIE S. TANKERSLEY
R.M.C.
GREENVILLE CO. S.C.