MICROFILMED

FILED
GREENVILLE CO. S.C.
JUN 14 12 13 PM '79
DONNIE S. TANKERSLEY
R.M.C.

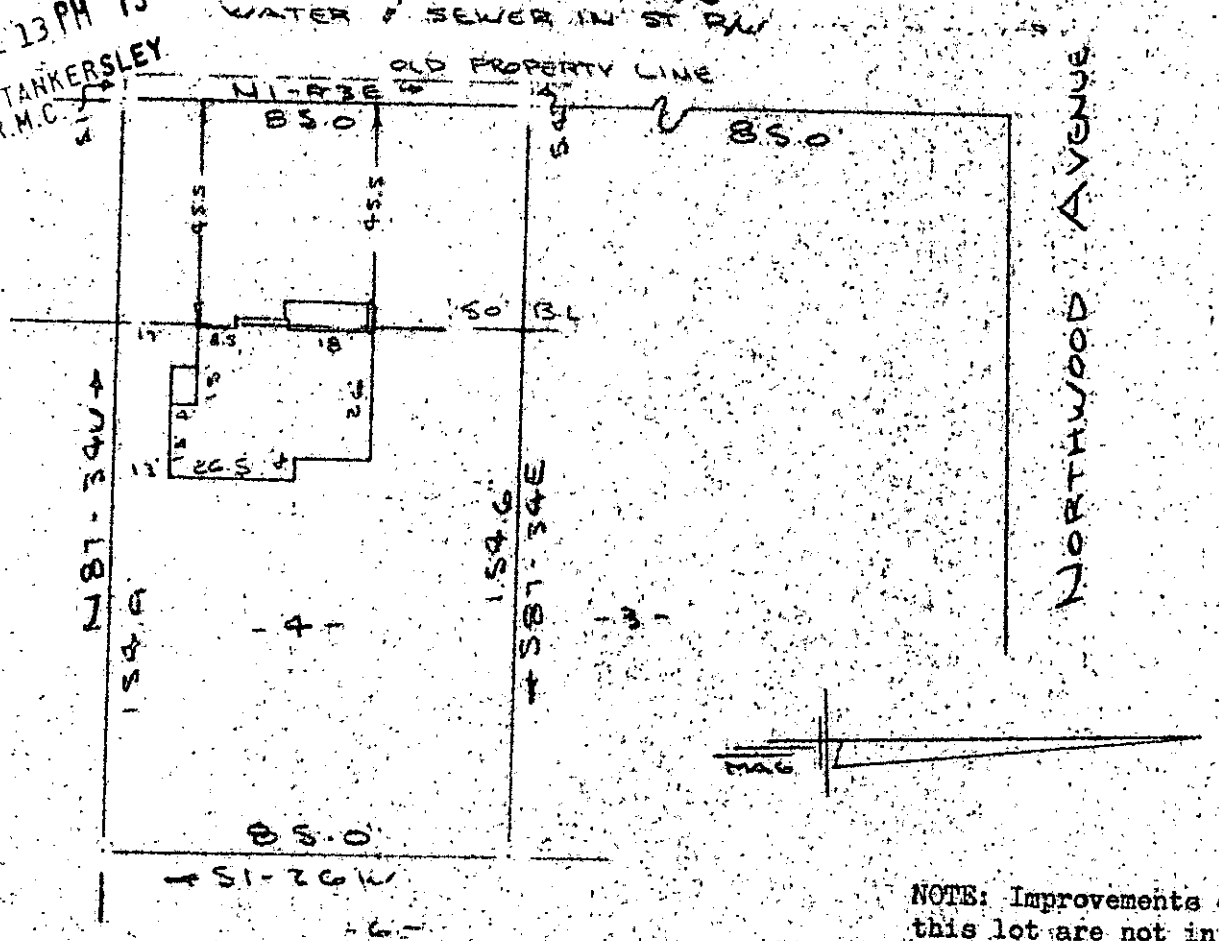

NOTE: Improvements on this lot are not in a flood hazard area.

PROPERTY OF

DAVID L. DORRITY & LEANNE A. DORRITY

GREENVILLE, S.C.

SCALE 1" = 40' 1 JUNE 1979

This is to certify that on the 1st day of June, 1979, I surveyed the property shown on this plat, being known as lot 4 on plat of FURMAN C. SMITH & HERMAN WALKER and recorded in the RMC Office Greenville County, S. C., in Plat Book " S " at Page 3; and also being known as PROPERTY OF DAVID L. DORRITY & LEANNE A. DORRITY and recorded in Plat Book at Page ; and that the property lines, walls and buildings located on said lot do not encroach or project on adjacent street or property, and that no adjacent walls or buildings encroach or project on said premises, and no power lines cross this property except as shown hereon.

7-H-23 37180

JUN 14 1979

CAROLINA SURVEYING CO.
112 Manly St.
Greenville, S. C.

R. B. Bruce

R. B. Bruce, RLS

GCTD 2 JN14 79 866

214 P 36A

184-1-89