


MICROFILMED

AMHERST AVENUE

FILED GREENVILLE CO. S. C.

JUN 14 3 58 PM '79  
DONNIE S. TANKERSLEY  
R.M.C.

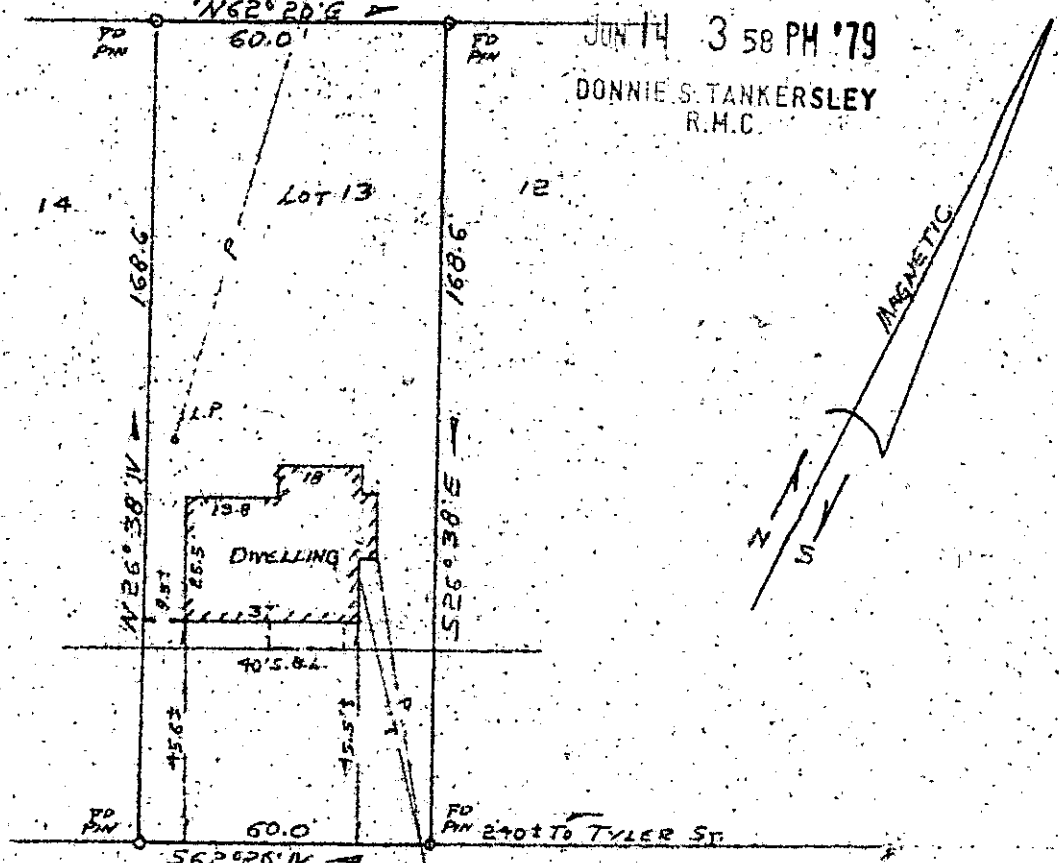

WAVERLY COURT

37158

PROPERTY OF  
DAVID M. ROPER

7H-25

AND

DEBRA P. ROPER

JUN 14 1979

GREENVILLE, SOUTH CAROLINA  
SCALE 1"=40'  
MAY 30, 1979

This is to certify that on May 30, 1979, I surveyed the property shown on this plat, known as Lot No. 13 of Augusta Heights as shown on a plat recorded in the RMC Office for Greenville Co., in Plat Book K at page 88, and that the property lines, walls and building are as shown hereon, and that the building located on said lot does not project nor encroach on adjacent streets or property, and that no adjacent walls or buildings project nor encroach on said lot, and that no utility lines cross this lot except as may be shown hereon.

Note  
This property is not located within a flood hazard area.

Survey by: Century Land Surveying Co.  
Greenville, South Carolina

*Richard D. V. Gooten*  
Richard D. V. Gooten  
S. C. L. S. No. 4678

GCTO -----3 JUN 14 79 1403

1.00CI