


JUN 15 1979

FILED GREENVILLE CO. S. C.

MICROFILMED

JUN 15 4 35 PM 1979
WATER & SEWER IN ST. R/W
DONNIE S. TANKERSLEY
R.M.C.

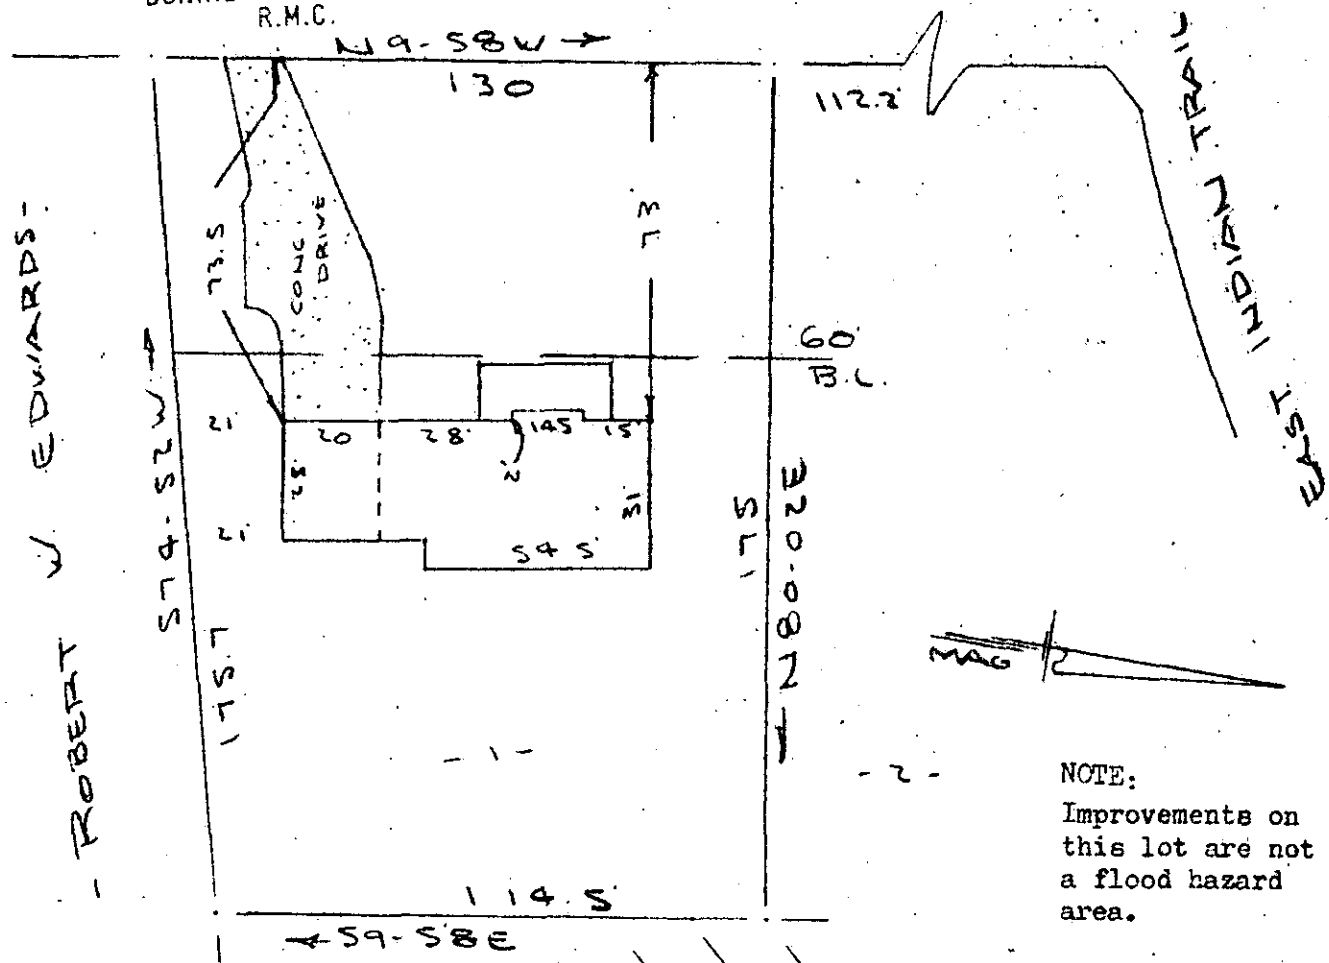

ROBERT W. EDWARDS

NOTE:
Improvements on
this lot are not in
a flood hazard
area.

PROPERTY OF
MAUD L. HEATON
NEAR GREENVILLE, S. C.
SCALE 1" = 40'
13 JUNE 1979

GCTO -----3 JUN 15 79

1.00CI

This is to certify that on the 13th day of June, 1979, I surveyed the property shown on this plat, being known as lot 1 on plat of SEVEN OAKS and recorded in the RMC Office Greenville County, S. C., in Plat Book " 4 - R " at Page 6; and that the property lines, walls and buildings are as shown hereon, and that the walls and buildings located on said lot do not encroach or project on adjacent street or property, and that no adjacent walls or buildings encroach or project on said premises, and no power lines cross this property except as shown hereon.


H - 29

37365

R. B. Bruce

R. B. Bruce, RLS #1952

CAROLINA SURVEYING CO.
112 Manly St.
Greenville, S. C.

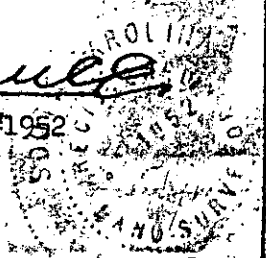

211 @ 10A