AF 10505

MICROFILMED

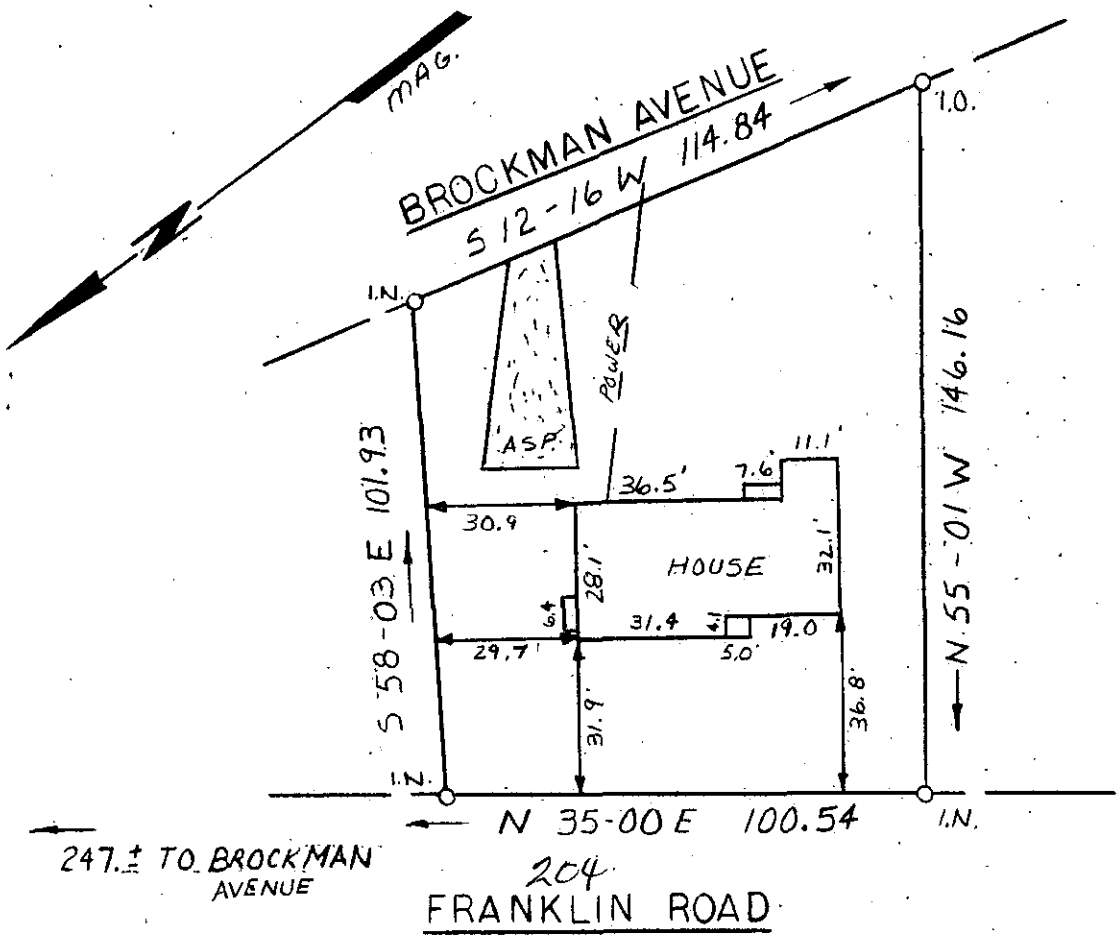

FILED
GREENVILLE CO. S.C.
JUN 18 12 01 PM '79
DONNIE S. TANKERSLEY
R.M.C.

This is to certify that on May 30, 1979, I surveyed the property shown on this plat, known as Part Block Book 163-4-1, recorded in the Tax Block Book Office of Greenville County, and that the property lines, walls, and buildings are as shown hereon; that the building located on said lot does not encroach or project on adjacent streets or property, and that no adjacent walls or buildings encroach or project on said premises, and that no utility lines cross this property except as shown hereon. This property is not located in a designated flood hazard area.

James R. Freeland

James R. Freeland RLS & PE 4781

1" = 40' 40 0 40 80 scale feet

JUN 18 1979

SOUTH CAROLINA REGISTERED LAND SURVEYOR NO. 4781 JAMES RALPH FREELAND

SEAL

STATE OF SOUTH CAROLINA
GREENVILLE COUNTY

PROPERTY OF
HOLLYTON INC.
J.H. COOPER

37540

7-H-30

FREELAND & ASSOCIATES
Engineers • Land Surveyors
GREENVILLE, S.C.

SURVEY	L.T.
DRAWN	S.P.
CHECK	S.P.
SCALE	1" = 40'
DATE	6-1-79
DWG. NO.	79-3432

GCTO -----2 JN18 79 1252 1.00CI