


This is to certify that on June 12, 1979, I surveyed the property shown on this plat, known as Lot 84 on Plat of Powderhorn Sec. 2, recorded in the RMC Office of Greenville County in Plat Book QQ on Page 151, and that the property lines, walls and buildings are as shown hereon; that the building located on said lot does not encroach or project on adjacent streets or property, and that no adjacent walls or buildings encroach or project on said premises, and that no utility lines cross this property except as shown hereon. This property is not located in a designated flood hazard area.

5' drainage & utility easement each side of all side & rear lot lines.


JUN 22 1979

James R. Freeland
 James R. Freeland RLS & PE 4781

38045

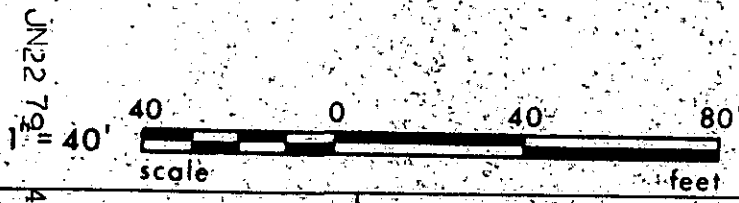

17-H-47

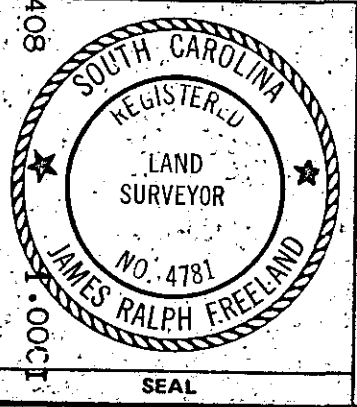

**STATE OF SOUTH CAROLINA
 GREENVILLE COUNTY**

**POWDERHORN
 SEC. 2 - LOT 84**

**PROPERTY OF
 LAWRENCE D. TRACY &
 TERRELL S. TRACY**

FREELAND & ASSOCIATES Engineers • Land Surveyors	
GREENVILLE, S.C.	
SURVEY	J.A.
DRAWN	M.C.
CHECK	M.C.
SCALE	1" = 40'
DATE	6-12-79
DWG. NO.	79-3485