MICROFILMED

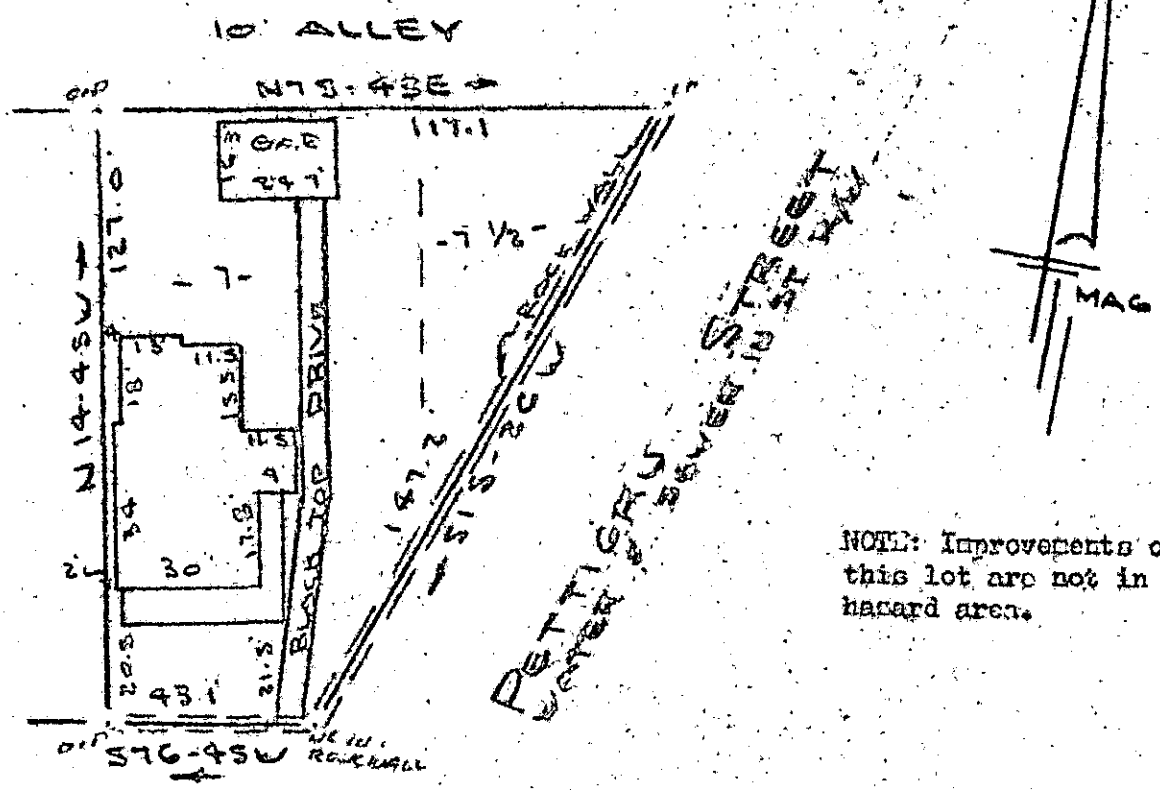

NOTE: Improvements on this this lot are not in a flood hazard area.

WHITSITT ST

PROPERTY OF
DANNY E. TAYLOR
GREENVILLE, S. C.
SCALE 1" = 40' 26 JUNE 1979

This is to certify that on the 26th day of June, 1979, I surveyed the property shown on this plat, being known as lot 7 and 7 ½ on plat of BOYCE LAWN ADDITION and recorded in the RMC Office Greenville County, S. C., in Plat Book " A " at Page 179; and that the property lines, walls and buildings are as shown hereon, and that the walls and buildings located on said lot do not encroach or project on adjacent street or property, and that no adjacent walls or buildings encroach or project on said premises, and no power lines cross this property except as shown hereon.

R. B. Bruce

R. B. Bruce, RLS #1952

JUN 29 1979

7-H-84

CAROLINA SURVEYING CO.
112 Manly St.
Greenville, S. C.

38944

GCTC
JUN 29 '79 1542
1.00CI
FILED
GREENVILLE CO. S.C.
JUN 29 3 26 PM '79
DONNIE S. TANKERSLEY
R.M.C.

213043

47-2-18