FILED
GREENVILLE CO. S.C.

JUL 3 2 46 PM '79

DONNIE S. TANKERSLEY
R.M.C.

MICROFILMED

DEVENGER PLACE

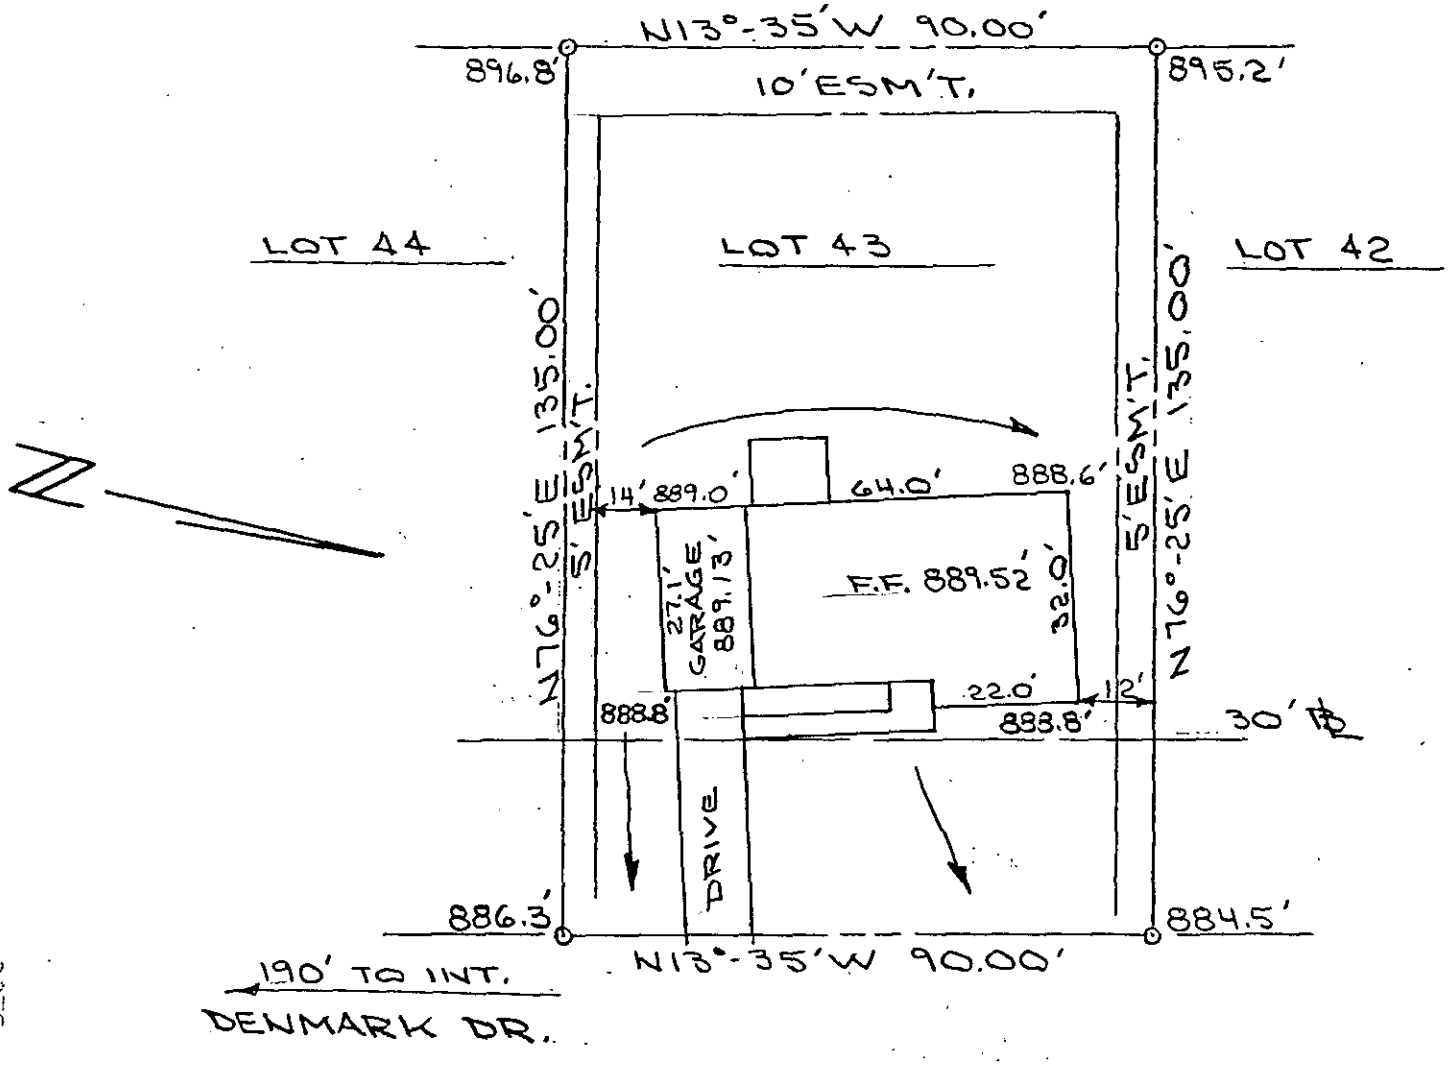

Greenville County
South Carolina

Date: June 27, 1979
Scale: 1" = 30'

Plat and Building Location of Lot 43, Westminster Village, Section II, recorded in plat book 5-P, page 93, Office of R.M.C., belonging to Richard Small and Andrea D. Small

I hereby certify that the measurements as shown on this plat are correct and there are no encroachments or projections other than shown.

7-H-97

Registered Land Surveyor S.C. #6571

422

HEANER ENGINEERING CO., INC.
GREENWOOD, S. C.

30 0 30 60

6CTG ----2 JL 3 79 1575