


This is to certify that on July 3, 1979, I surveyed the property shown on this plat, known as Lot 2 on Plat of Shiloh Estates, Sec. 2, recorded in the RMC Office of Greenville County in Deed Book 1072 on Page 895, and that the property lines, walls and buildings are as shown hereon; that the building located on said lot does not encroach or project on adjacent streets or property, and that no adjacent walls or buildings encroach or project on said premises, and that no utility lines cross this property except as shown hereon. This property is not located in a designated flood hazard area.

drainage & utility easement along all side & rear lot lines.

554 ✓ 7-J-5 JUL 5 1979

James R. Freeland

James R. Freeland RLS & PE 4781

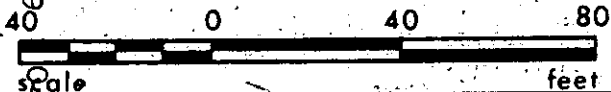

574.1-1-42



**STATE OF SOUTH CAROLINA
GREENVILLE COUNTY**

**SHILOH ESTATES
SEC. 2 - LOT 2
PROPERTY OF
HENNON H. STYLES
&
JUDITH W. STYLES**

FREELAND & ASSOCIATES
Engineers • Land Surveyors

GREENVILLE, S.C.

SURVEY	D.H.
DRAWN	M.C.
CHECK	M.C.
SCALE	1" = 40'
DATE	7-3-79
DWG. NO.	79-3618