


- 110 -

FILED  
GREENVILLE CO. S. C.  
JUL 10 3 08 PM '79  
DONNIE S. TANKERSLEY  
R.M.C.

KENWOOD LANE CHESTON

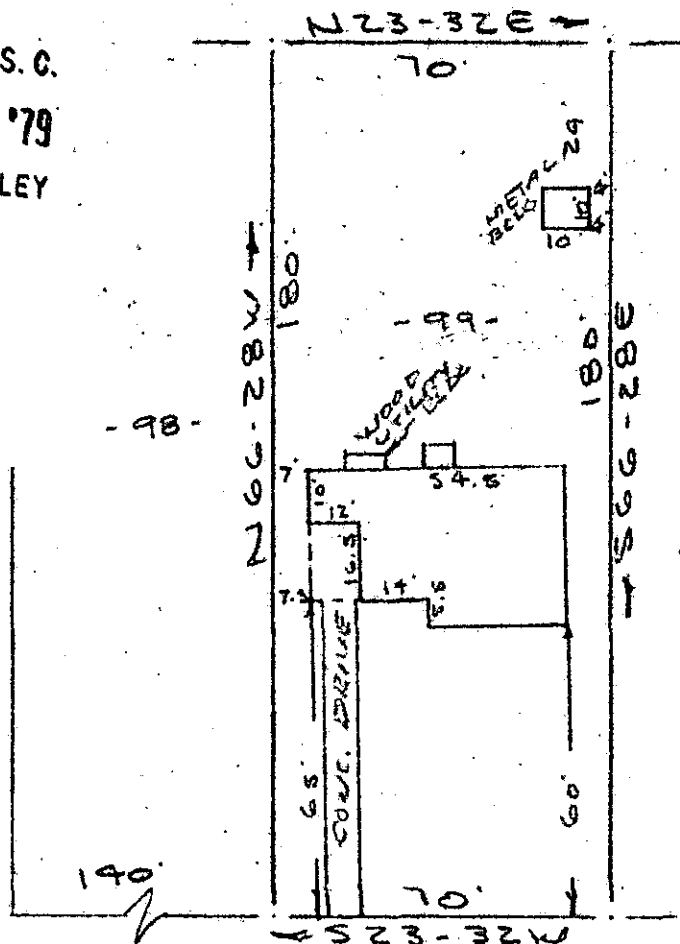

NOTE: Improvements on this lot are not in a flood hazard area.

McDONALD STREET  
WATER & SEWER IN ST R/W

PROPERTY OF  
KAREN HAYES GREGORY  
NEAR GREENVILLE, S.C.  
SCALE: 1"=40'  
5 JULY 1979

GCTC --- 1 JUL 10 1979

This is to certify that on the 5th day of July, 1979, I surveyed the property shown on this plat, being known as lot 99 on plat of NORTH HILLS and recorded in the REC. Office Greenville County, S. C., in Plat Book " H " at Page 138; and that the property lines, walls and buildings are as shown hereon, and that the walls and buildings located on said lot do not encroach or project on adjacent street or property, and that no adjacent walls or buildings encroach or project on said premises, and no power lines cross this property except as shown hereon.

25-27 ✓

1090

*R. B. Bruce*

R. B. Bruce, RLS 12952-0

1.00CI

CAROLINA SURVEYING CO.  
112 Manly St.  
Greenville, S. C.

