

FURMAN UNIVERSITY

MICROFILMED

FILED
GREENVILLE CO. S. C.

OCT 29 9 09 AM '79

GONNIE S. TANKERSLEY
R.M.C.

Note: Improvements
on this lot are not in
a flood hazard area.

PROPERTY OF
JOHN E. MOON
NANCY JONES MOON
NEAR GREENVILLE, S. C.
SCALE: 1"=100' 23 OCT 1979

7-K-36

14272

DUGGAN
2,800
305.3 N


SC8-21E
372'

M81-5 S
502 S

M81-5 S



SEPTIC TANK
ON LOT.

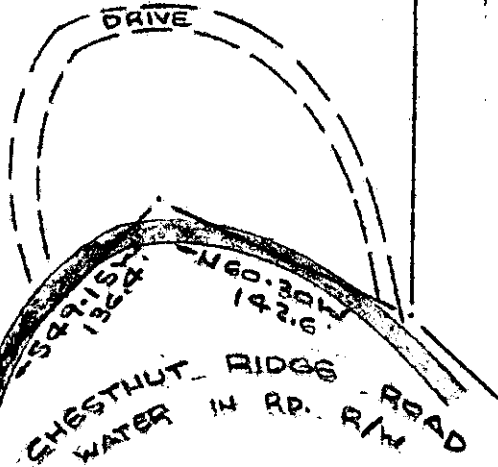

81.65
142.6
136.4
54.9
15.7

DUGGAN

This is to certify that on the 23rd day of October, 1979, I surveyed the property shown on this plat, being known as 4.08 acres of plat of PROPERTY OF JUSTIN D. LAMBLE and recorded in the REC Office Greenville County, U. C., in Plat Book "AA" at Page 45 B and also being known as PROPERTY OF JOHN E. MOON & NANCY JONES MOON and recorded in Plat Book at Page ; and that the property lines, walls and buildings are as shown hereon, and that the walls and buildings located on said lot do not encroach or project on adjacent street or property, and that no adjacent walls or buildings encroach or project on said premises, and no power lines cross this property except as shown hereon.

CAROLINA SURVEYING CO.
112 Mainly St.
Greenville, S. C.

R. B. Bruce
R. B. Bruce, RLS/1952