

I CERTIFY THAT THIS PLAT WAS PREPARED FROM AN ACTUAL FIELD SURVEY & THAT IT WAS MADE UNDER MY SUPERVISION.


Haun H. Chapman
S. C. REG. LAND SURVEYOR NO. 3616

- LEGEND**
- SANITARY SEWER LINE & MANHOLE
 - WATER METER
 - ⊕ POWER & TELEPHONE POLES
 - ⊕ LIGHT POLE
 - POWER & OR TELEPHONE LINES
 - 3" BOARD FENCE
 - I.P. IRON PIN
 - ▨ CONCRETE
 - ▨ ASPHALT
 - UNDERGROUND TELEPHONE BOX
 - CURB
 - WALL

▨ COMMON ELEMENTS

▨ LIMITED COMMON ELEMENTS

FILED
GREENVILLE CO. S. C.
AUG 7 4 32 PM '79
DONNIE S. TARKERSLEY
R.M.C.

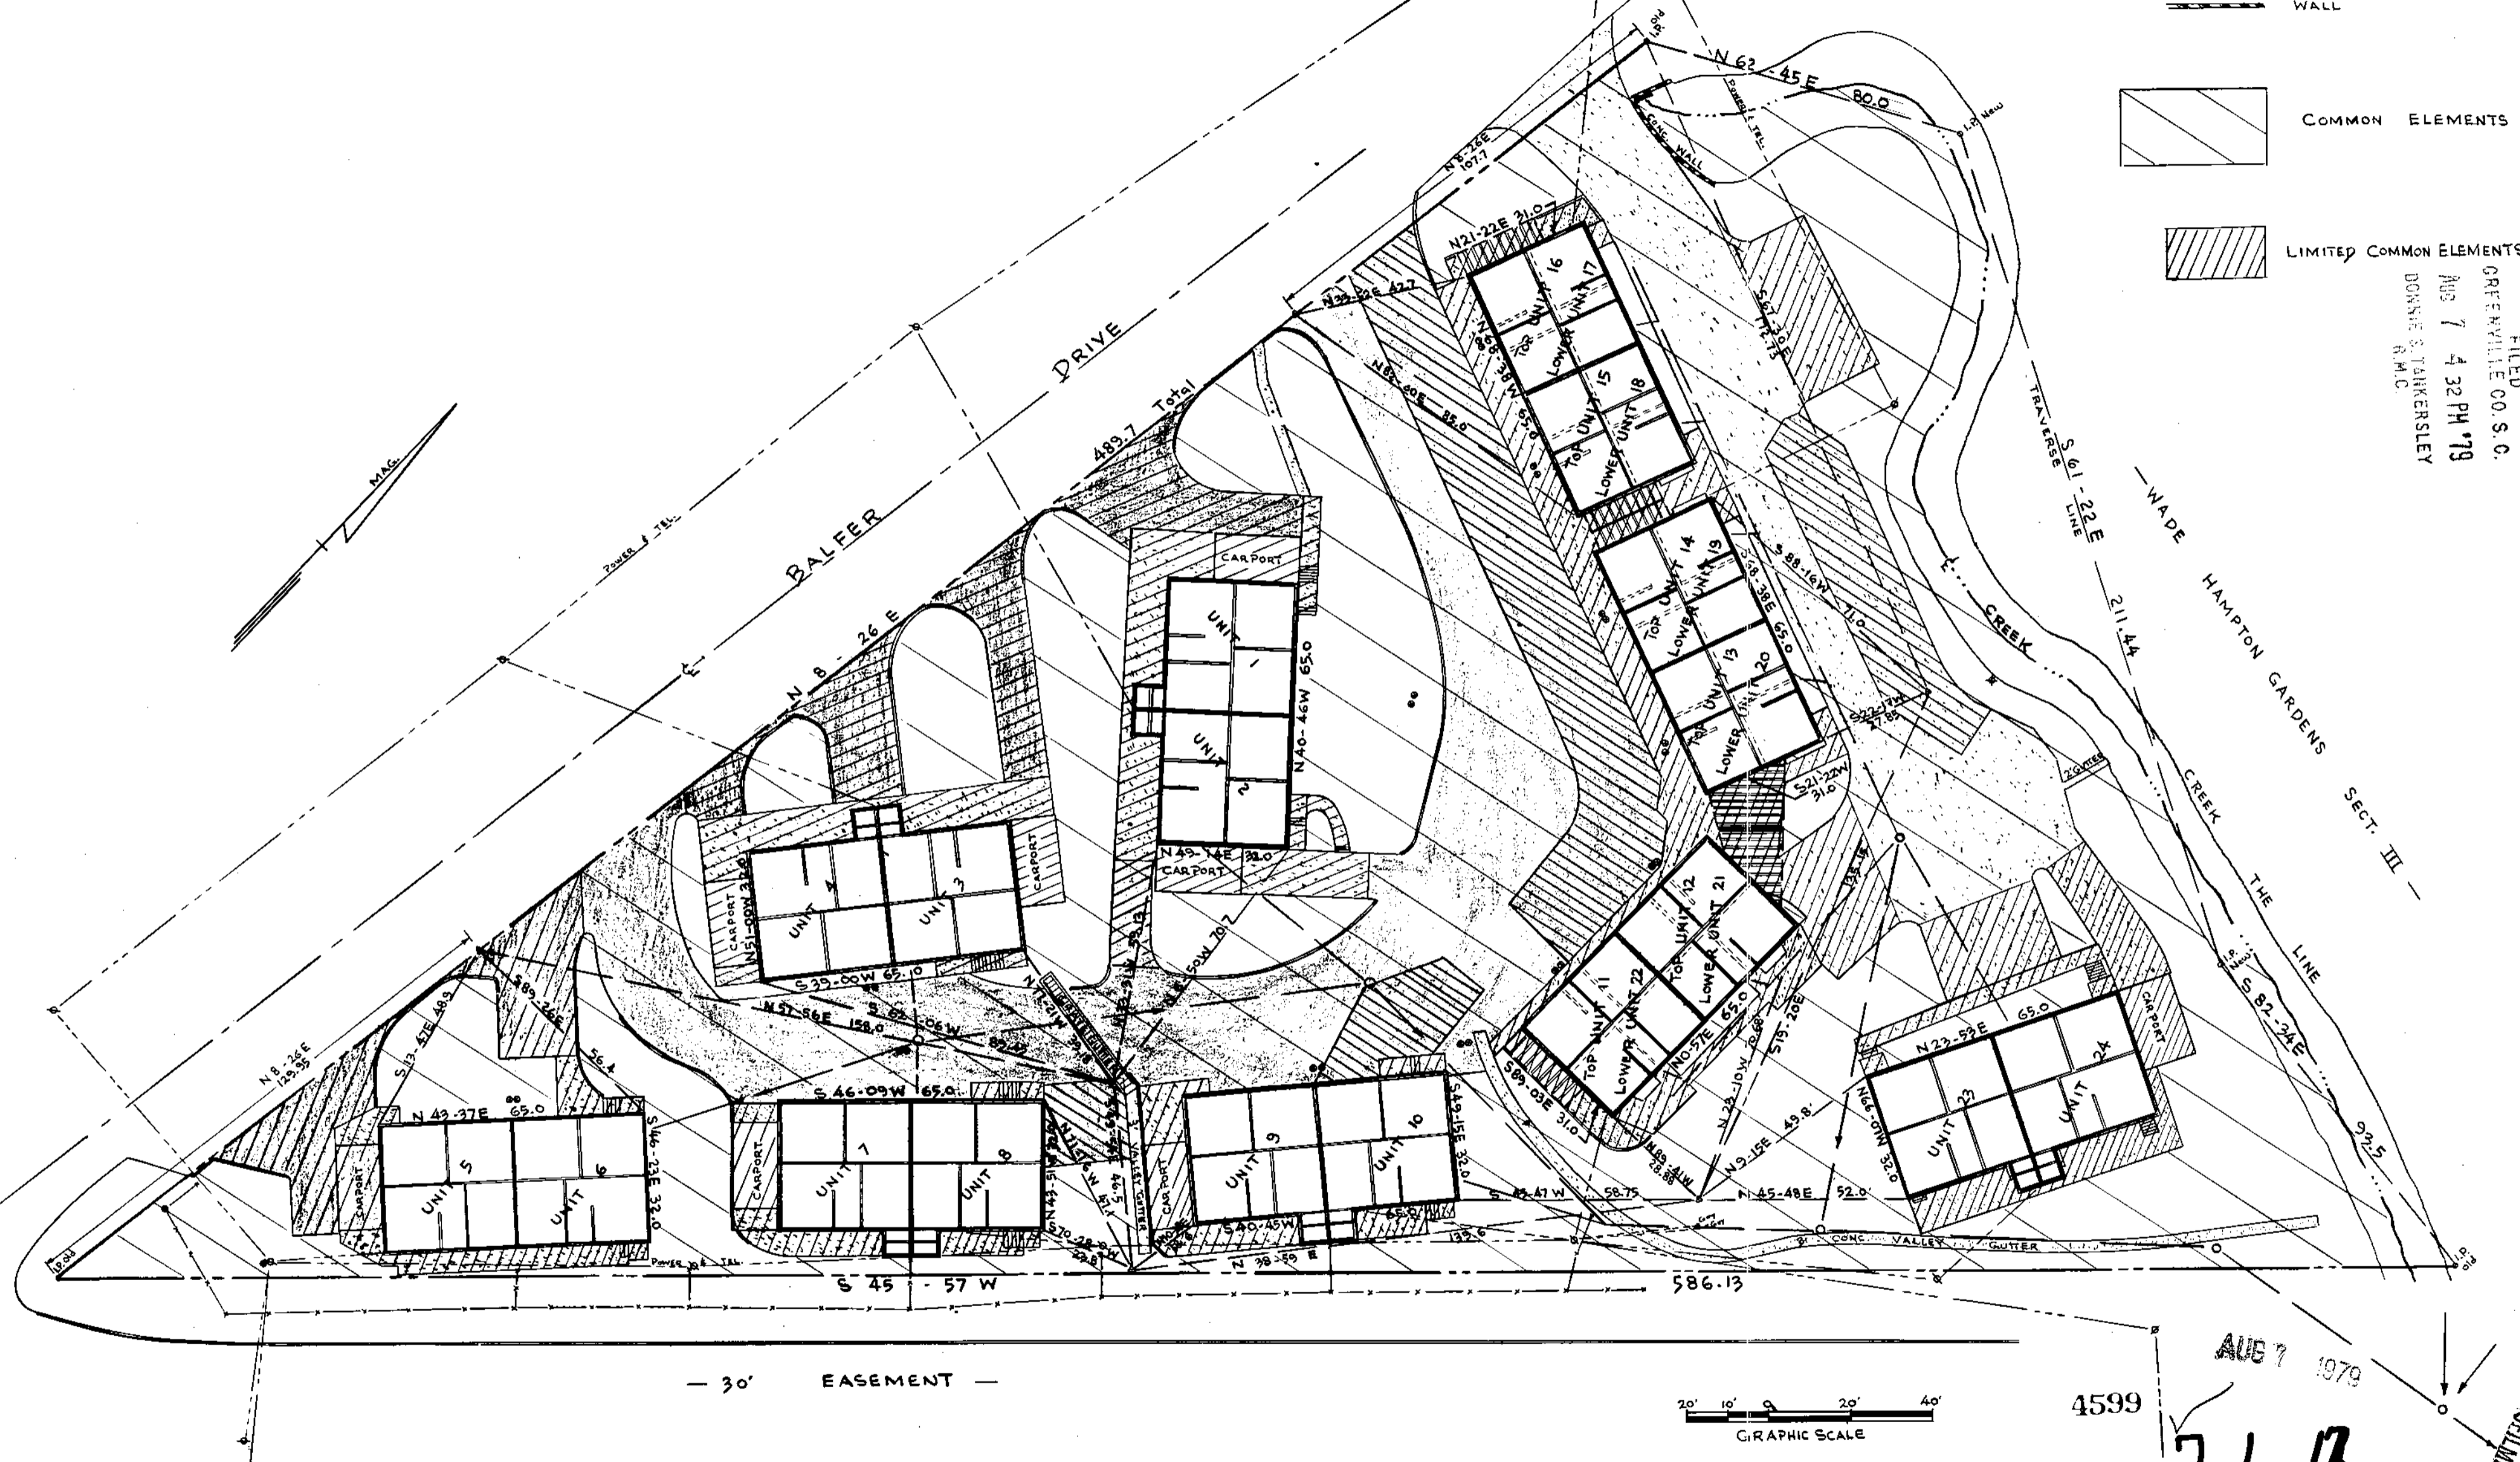

NO.	DATE	REVISION	BY	NO.	DATE	REVISION	BY

PIEDMONT
ENGINEERS • ARCHITECTS • PLANNERS
480 PARK AVENUE • GREENVILLE, SOUTH CAROLINA 29602



PLOT PLAN UNIT IDENTIFICATION & SURVEY FOR
BALFER COURT
A HORIZONTAL PROPERTY REGIME
GREENVILLE COUNTY, S.C.
SCALE: 1" = 20' JULY 12, 1979



PROJ. MGR: CRAIN	DRAWING NO.
DRAWN: HUNT	
CHECKED:	
APPROVED:	
DATE:	LAST REV. NO:
JOB NO:	DATE REV: