
MICROFILMED

NOTE: Improvements on this lot are not in a flood hazard area.

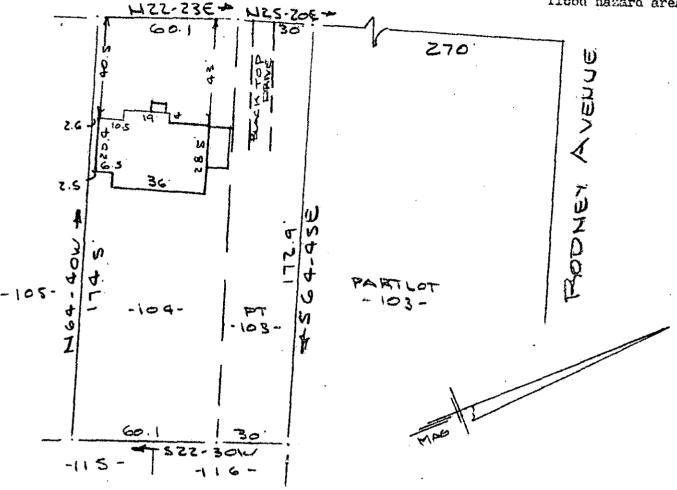

PROPERTY

OF MICHAEL W TAYLOR & CHARLOTTE C TAYLOR

GREENVILLE

SCALE: 1'0 40: 30:2441979

. This is to certify that on the 50th day of July, 1979, I surveyed the property chown ≥ on this plat, being known as lot 104 and part of lot 103 on plat of SANS SOUCI EDIVELOPHENT CC. and recorded in the RNC Office Greenville County, S. C., in Plat Book "H" at Pages 186 & 187; and that the property lines, walls and buildings are The shown hereon, and that the walls and buildings located on said lot do not encreach or project on adjacent street or property, and that no adjacent wells or buildings encreach or project on said premises, and no power lines cross this property mexcept as shown hereon.

3942

R. B. Bruce, RIS 319

DONNIE S. TANKE**RSLEY** R.M.C.

SURVEYTIG CHEENALTE CO' 2'C' Orccaville. FILED

AUG

213667

ica