REF: TAX MAP NO. 686.1-4-8

MICROFILMED

FILED
GREENVILLE CO. S.C.
AUG 7 4 22 PM '79
DONNIE S. TANKERSLEY
R.M.C.

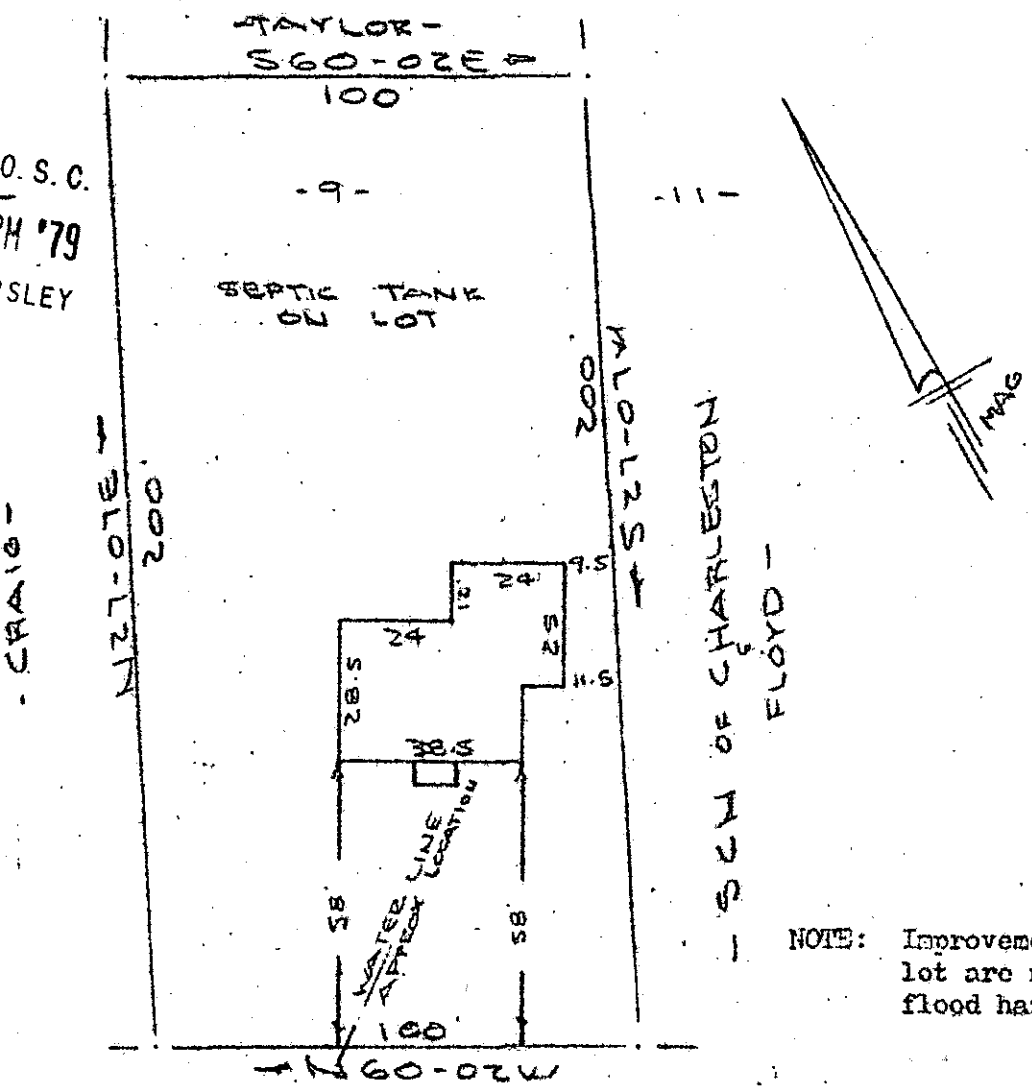

NOTE: Improvements to this lot are not in a flood hazard area.

SUNRISE DRIVE
MAIN WATER LINE IN REAR OF LOTS ON SOUTHERN SIDE OF RD

PROPERTY OF

ALBERT Q TAYLOR, JR

NEAR CAESARS HEAD, GREENVILLE COUNTY, S.C.

SCALE: 1" = 40' 11 JULY 1979

AUG 7 1979

This is to certify that on the 11th day of July, 1979, I surveyed the property shown on this plat, being known as lot 9 on plat of CAESARS HEAD SEC. A and recorded in the RMC Office Greenville County, S.C., in Plat Book " G " at Page 122 & 123; and that the property lines, walls and buildings are as shown hereon, and that the walls and buildings located on said lot do not encroach or project on adjacent street or property, and that no adjacent walls or buildings encroach or project on said premises, and no power lines cross this property except as shown hereon.

7-M-33

R. B. Bruce

R. B. Bruce, RLS #1932

CAROLINA SURVEY COMPANY
112 Manly Street
Greenville, S.C.

4598

GCTO ----- 3 AU 7 79 1474

3.00CI