


- 20 -  
- 19 -  
- 18 -  
FILED N 71-34 E -  
GREENVILLE CO. S. C. 9 S.

AUG 13 2 51 PM '79  
DONNIE S. TANKERSLEY  
R.M.C.

NOTE: Improvements on this lot are not in a flood hazard area.

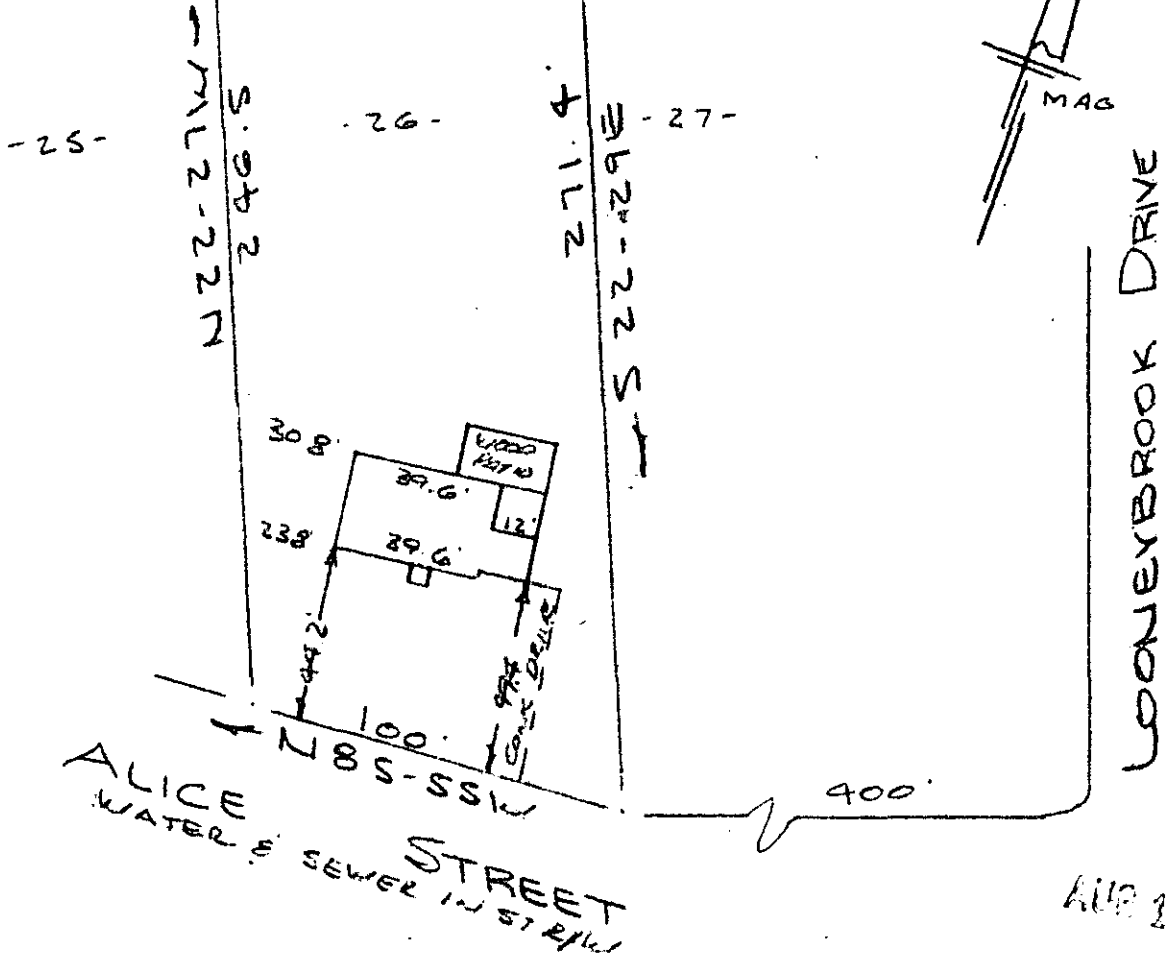

ALICE STREET  
WATER & SEWER IN STREET

ALL 23

PROPERTY OF  
RANDALL K. KING & VICKIE H. KING  
FOUNTAIN INN, S.C.  
SCALE 1" = 30'. 10 AUG 1979

GCTO ----- 3 AUG 13 79

This is to certify that on the 10th day of August, 1979, I surveyed the property shown on this plat, being known as lot 26 on plat of SUN SET HEIGHTS and recorded in the REC Office Greenville County, S. C., in Plat Book " 00 " at Page 314 and also being known as PROPERTY OF RANDALL K. KING & VICKIE H. KING and recorded in Plat Book at Page ; and that the property lines, walls and buildings are as shown hereon, and that the walls and buildings located on said lot do not encroach or project on adjacent street or property, and that no adjacent walls or buildings encroach or project on said premises, and no power lines cross this property except as shown hereon.

✓ 7 M-46

5220

R. B. Bruce  
R. B. Bruce, RLS 1952

3.00CI

CAROLINA SURVEYING CO.  
112 Manly St.  
Greenville, S. C.