
SHELBURUE ROAD WATER IS SEVER IN RD RAL

Note: Improvements on this lot are not in a flood hazard area.

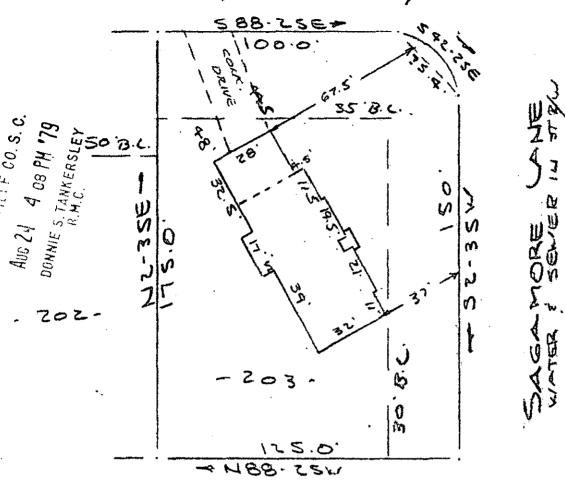

PROPERTY OF
WILLIAM W. MIMS & ERNESTENE J. MIMS
HEAR GREENVILLES.C.
SCALE 1": 40" 23 AUG 1979

This is to certify that on the 23rd day of August, 1979, I surveyed the property shown on this plat, being known as lot 203 on plat of SECTION B - GOWER ESTATES and recorded in the RMC Office Greenville County, S. C., in Plat Book " XX " at Page 36; and that the property lines, walls and buildings are as shown hereon, and that the walls and buildings located on said lot do not encroach or project on adjacent street or property, and that no adjacent walls or buildings encroach or project on said premises, and no power lines cross this property except as shown hereon.

6738

R. B. Bruce, RIS #1952

7-21-94

CAROLINA SURVEYING CO.
112 Manly St.
Greenville, S. C.

3.00 A4 Greenville, S.

48 SE JU 21E