


MICROFILMED

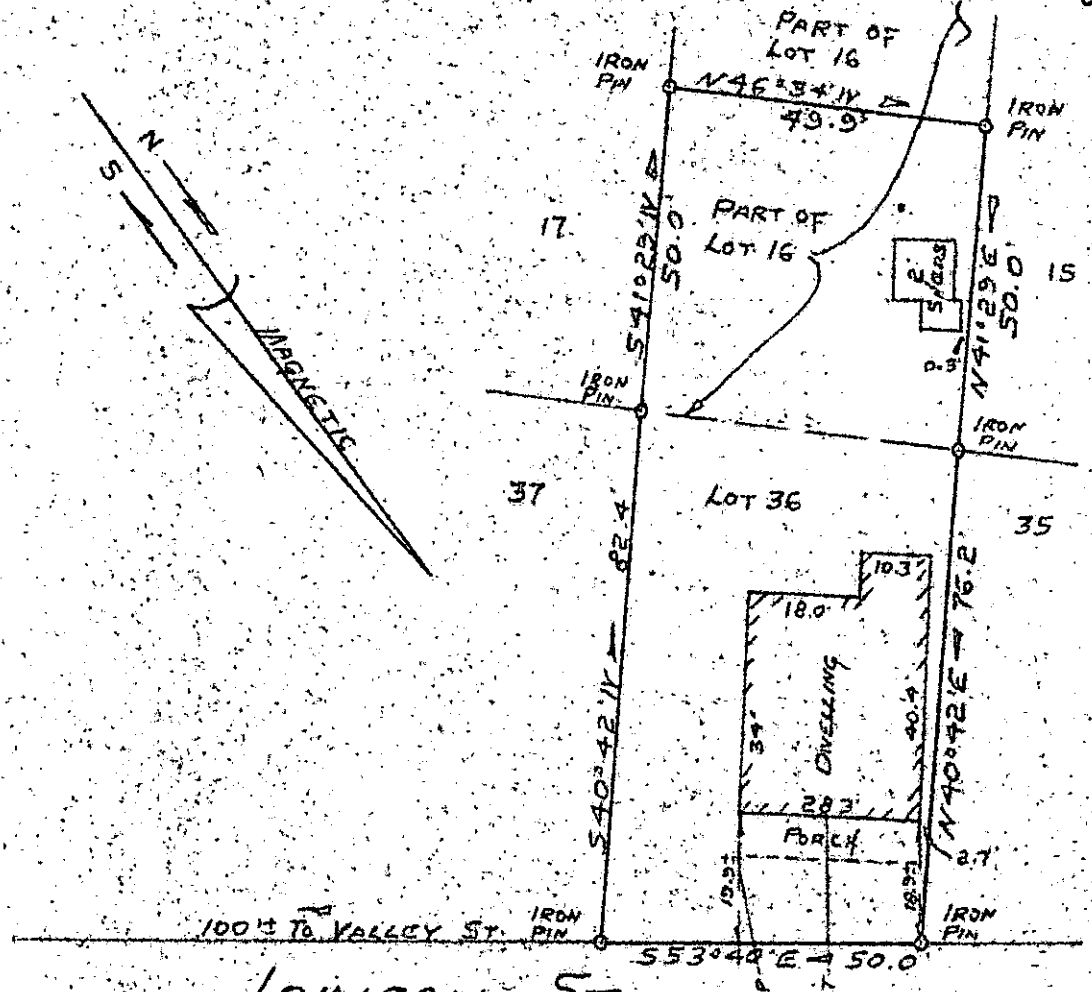

LAINSON ST

PROPERTY FOR  
 DUNCAN H. HARVIN  
 AND  
 REBECCA H. HARVIN  
 NEAR GREENVILLE, SOUTH CAROLINA  
 SCALE 1" = 30' AUG 23, 1979

This is to certify that on August 23, 1979, I surveyed the property shown on this plat, known as Lot No. 36 of Property of American Bank & Trust Co. and shown on a plat recorded in the RMC Office for Greenville County, in Plat Book F, page 22, and also part of Lot No. 16 of Westview, Subdivision of Lands of Mr. B. F. Martin, as shown on a plat also recorded in the RMC Office for Greenville County, in Plat Book F, page 140, and that the property lines, walls, and buildings are as shown hereon, and that the building located on said lot does not project nor encroach on adjacent streets or property, and that no adjacent walls or buildings project nor encroach on said lot, and that no utility lines cross this lot except as may be shown hereon.

NOTE: This property is not located within a flood hazard area.

Survey by: Richard D. Wooten, Jr.  
 Greenville, South Carolina

7393

7-N-12

Aug 30 3 45 PM '79

GREENVILLE CO. S. C.

FILED

AUG 31 1979

8296 S. C. R. L. S. No. 4674

GCTO -----3 AU 30 79 3.00CI