

MICROFILMED

WELCOME ROAD


Note: Improvements on this lot are not in a flood hazard area.

FILED
GREENVILLE CO. S.C.
SEP 17 4 27 PM '79
DONNIE S. TANKERSLEY
R.M.C.

GCTO ----- 3 SE 17 7

ANDREW F. ATKINS, JR.

N64-35E
69.3

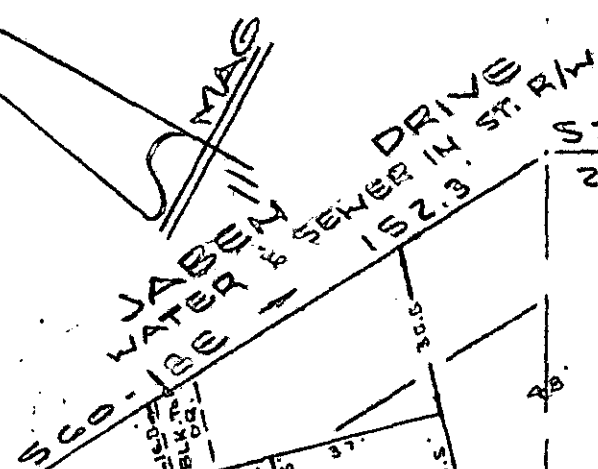

- N 28-21W 157.1 T&T. -
- A. T. SULLIVAN, JR - - U - HALL -

PROPERTY OF
JAMES E. HORKY
NEAR GREENVILLE, S. C.
SCALE: 1" = 40' 31 AUG 1979

This is to certify that on the 31st day of August, 1979, I surveyed the property shown on this plat, being known as lot 12 and lot 13 on plat of PLAT NO. 2 PROPERTY OF B. P. CRENSHAW and recorded in the RMC Office Greenville County, S. C., in Plat Book " LL " at Page 142 and also being known as PROPERTY OF JAMES E. HORKY and recorded in the RMC Office in Plat Book at Page ; and that the walls and buildings are as shown hereon, and that the walls and buildings located on said lot do not encroach or project on adjacent street or property, and that no adjacent walls or buildings encroach or project on said premises, and no power lines cross this property except as shown hereon.

7-N-59 9291 R. B. Bruco

R. B. Bruco, RLS #1952

CAROLINA SURVEYING CO.
112 Manly St.
Greenville, S. C.

SEP 17 1979

3.0001

714/3-A

740 0 33