


Thomas D. Lindsey

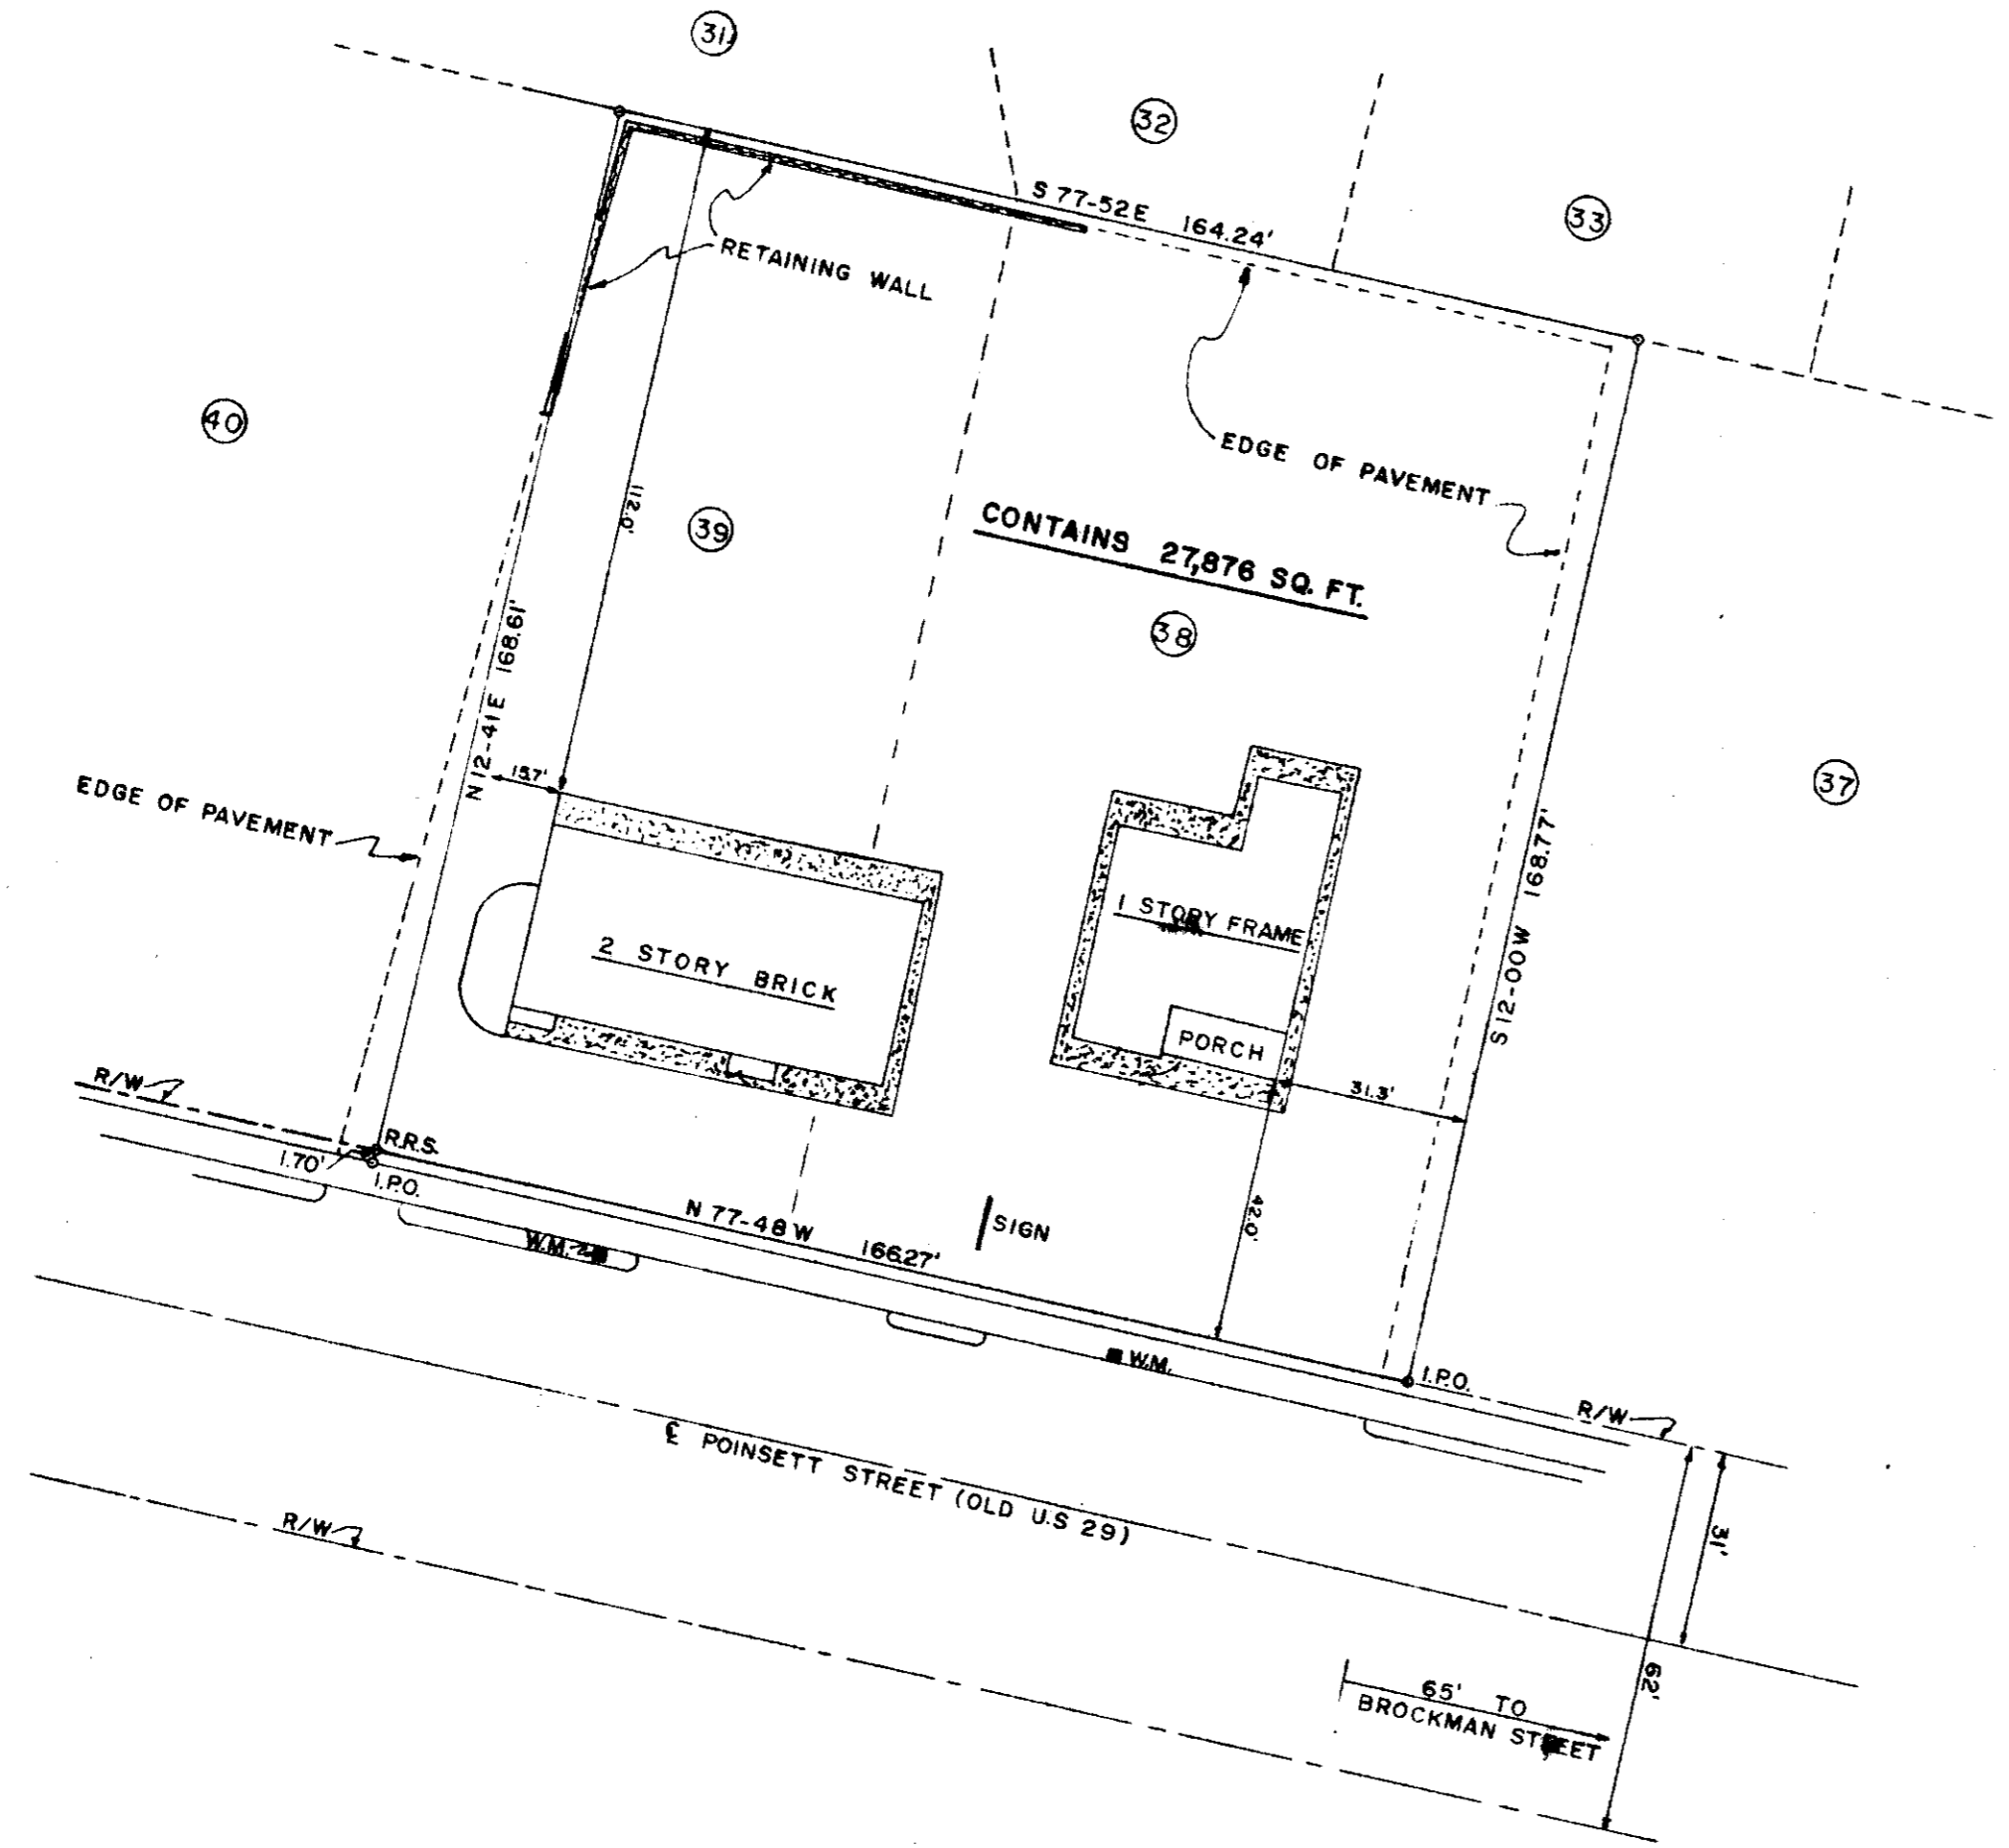


DEEDS	
BOOK	PAGE
853	71
723	372
PLAT	
BOOK	PAGE
J	22,23

FILED
GREENVILLE CO. S.C.
FEB 8 12 38 PM '80
DONNIE S. TANKERSLEY
R.M.C.

THIS PLAT IS SUBJECT TO ALL RESTRICTIONS, EASEMENTS, RIGHTS-OF-WAY, ROADWAY, AND ZONING ORDINANCES OF RECORD, ON RECORDED PLATS, OR ON THE PREMISES.

I HEREBY CERTIFY THAT I HAVE SURVEYED THIS PROPERTY AND THAT THE MEASUREMENTS SHOWN ARE CORRECT.

24212
7-0-76
FEB 8 1980

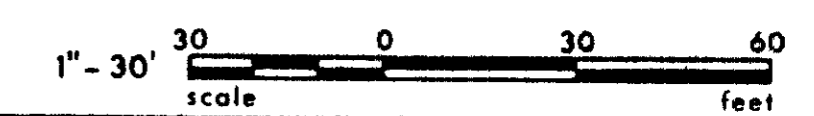

LOTS 38 & 39 W. H. BROCKMAN ESTATE		
CITY OF GREER	GREENVILLE CO.,	SOUTH CAROLINA
SCALE: 1" = 30'	APPROVED BY	DRAWN BY TDL
DATE: 1-31-1980	SURVEYED FOR J. LEON HIX	
LINDSEY & ASSOCIATES		DRAWING NUMBER 1211