AF 10755A

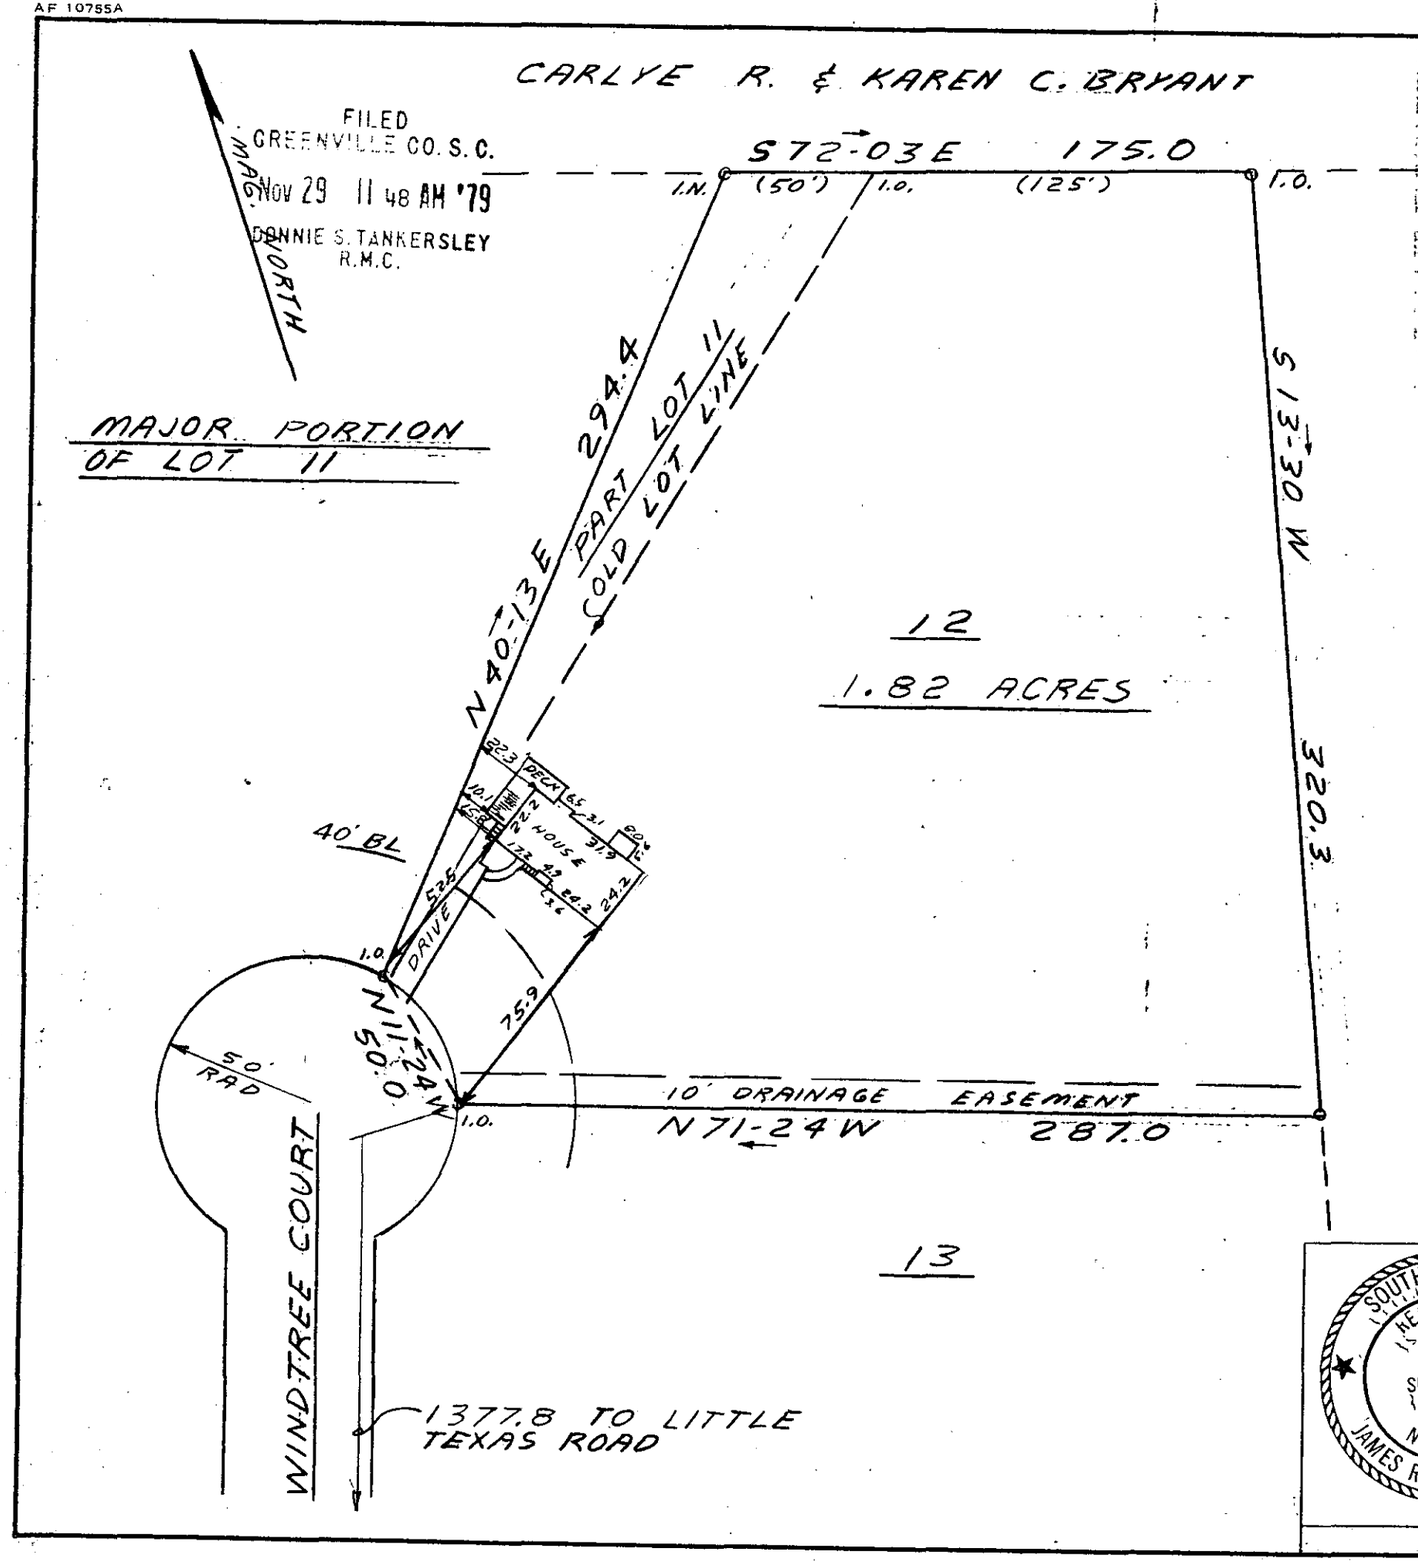

This is to certify that on November 20, 1979, I surveyed the property shown on this plat, known as Lot 12 and Pt. Lot 11 on plat of Windtree, recorded in the RMC Office of Greenville County in Plat Book 6H on page 12, and that the property lines, walls and buildings are as shown hereon; that the building located on said lot does not encroach or project on adjacent streets or property, and that no adjacent walls or buildings encroach or project on said premises, and that no utility lines cross this property except as shown hereon. This property is not located in a designated flood hazard area.

5° drainage and utility easement each side of all side and rear lot lines.

James R. Freeland, RLS & PE 4781

GCTO -----3 NO29 79 034 5.00CE

7Q-59

17938

SOUTH CAROLINA REGISTERED LAND SURVEYOR NO. 4731 JAMES RALPH FREELAND

SEAL

STATE OF SOUTH CAROLINA
GREENVILLE COUNTY

WINDTREE
LOT 12 & PART LOT 11
PROPERTY OF
BROWN ENTERPRISES
OF S.C. INC.

FREELAND & ASSOCIATES
Engineers • Land Surveyors
GREENVILLE, S.C.

SURVEY	J.R.F.
DRAWN	J.R.F.
CHECK	MC
SCALE	1" = 50'
DATE	11-20-79
DWG. NO.	79-4445

MICROFILMED