
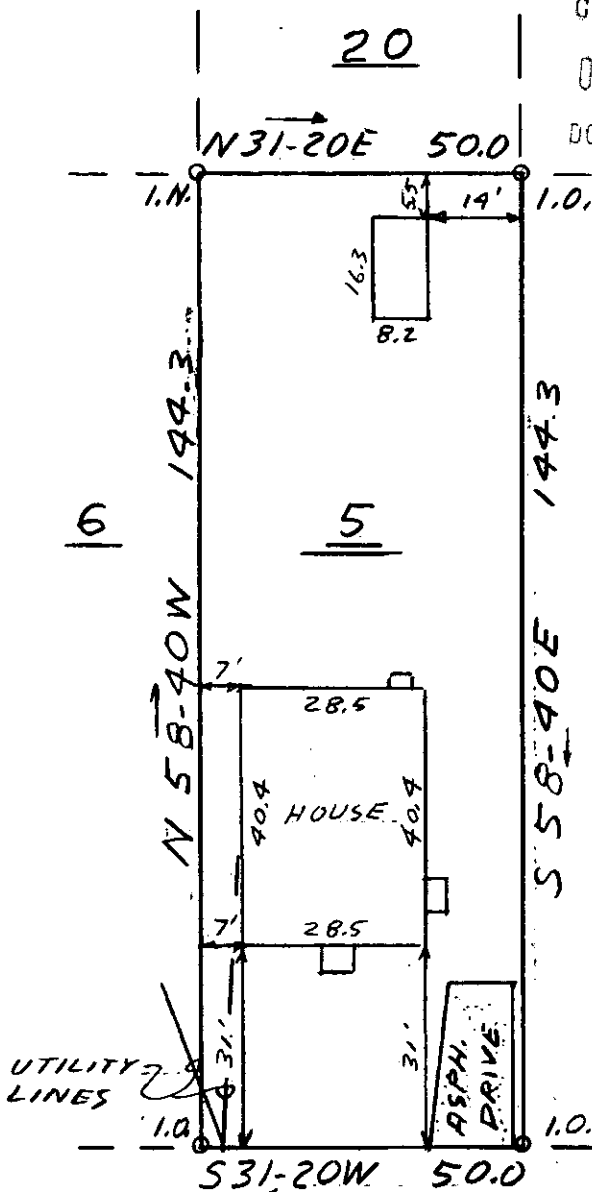


FILED  
GREENVILLE CO. S. C.  
OCT 1 1 40 PM '79  
DONNIE S. TANKERSLEY  
R.M.C.

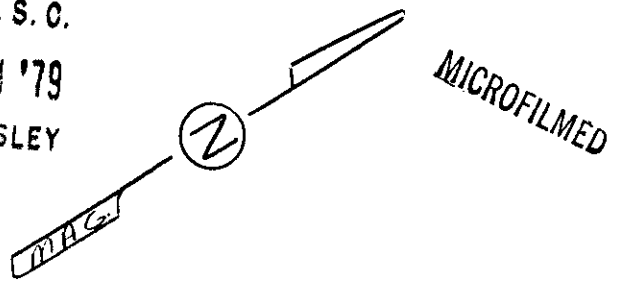

This is to certify that on September 26, 1979, I surveyed the property shown on this plat, known as Lot 5 on plat of Fair Heights Sec. B, recorded in the RMC Office of Greenville County in Plat Book F on page 256 and that the property lines, walls and buildings are as shown hereon; that the building located on said lot does not encroach or project on adjacent streets or property, and that no adjacent walls or buildings encroach or project on said premises, and that no utility lines cross this property except as shown hereon.

This property is not located in a designated flood hazard area.

OCT 1 1979

*James R. Freeland*  
James R. Freeland RLS & PE 4781

PARKINS MILL RD.

11054

FR-2



265-11-6



STATE OF SOUTH CAROLINA  
GREENVILLE COUNTY

FAIR - HEIGHTS  
SECTION B - LOT 5  
PROPERTY OF  
JOHN H. CAMPBELL

FREELAND & ASSOCIATES  
Engineers • Land Surveyors

GREENVILLE, S.C.

SURVEY	DH
DRAWN	JRF
CHECK	M.C.
SCALE	1" = 30'
DATE	9-26-79
DWG. NO.	79-416