MICROFILMED

AF 10505

FILED
GREENVILLE CO. S.C.
OCT 1 2 28 PM '79
DONNIE S. TANKERSLEY
R.M.C.

BLK BK 615.5-1-5

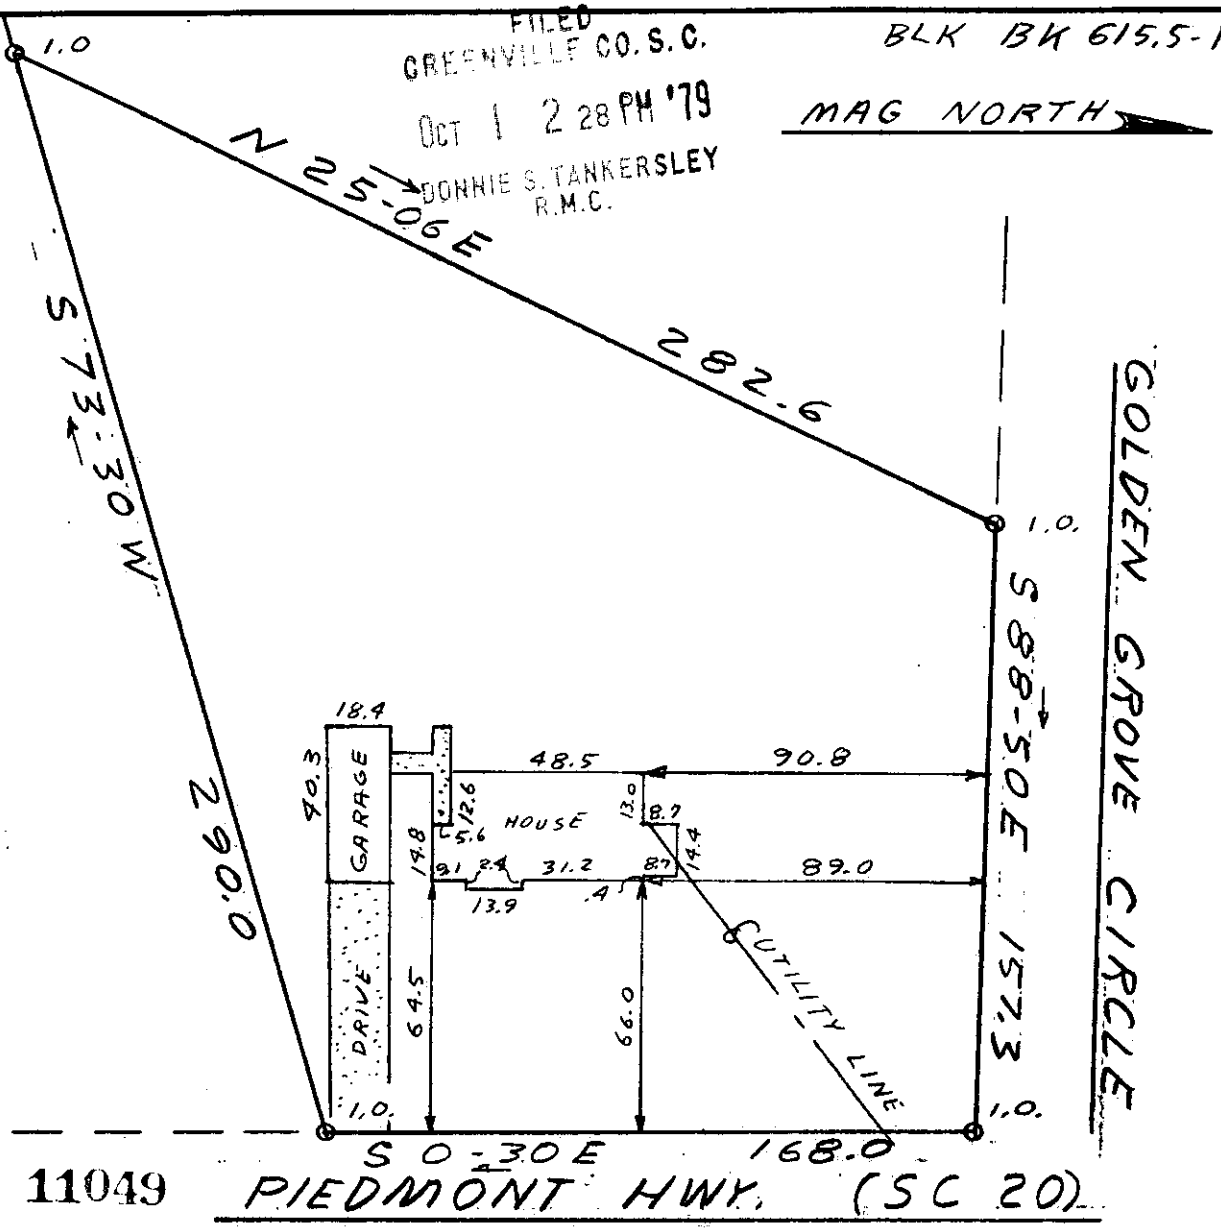

This is to certify that on September 28, 1979, I surveyed the property shown on this plat, known as Charles A. and Jewel H. Buckner Property, recorded in the RMC Office of Greenville County in Deed Book 1022 on page 446, and that the property lines, walls and buildings are as shown hereon; that the building located on said lot does not encroach or project on adjacent streets or property, and that no adjacent walls or buildings encroach or project on said premises, and that no utility lines cross this property except as shown hereon. This property is not located in a designated flood hazard area.

7R-5

James R. Freeland
James R. Freeland RLS & PE 4781

SOUTH CAROLINA REGISTERED LAND SURVEYOR NO. 4781 JAMES RALPH FREELAND

SEAL

STATE OF SOUTH CAROLINA
GREENVILLE COUNTY

PROPERTY OF

MARY L. MONTGOMERY
KENNETH D. MONTGOMERY

FREELAND & ASSOCIATES
Engineers • Land Surveyors
GREENVILLE, S.C.

SURVEY	D. H.
DRAWN	JRF
CHECK	mL
SCALE	1" = 50'
DATE	9-28-79
DWG. NO.	79-4132.

094 RT 1E 3.00 A4