

J. C. GOODWIN
N 88.00 E
186.5

W.M.C. & JEANNIE Z. MORRISON
MICROFILMED

FILED
GREENVILLE CO. S.C.

OCT 3 11 16 AM '79

DONNIE S. TANKERSLEY
R.M.C.

WEST HEDGE STREET
WATER & SEWER IN ST. R/W
N 88.00 E 186.5
S 17.47 E 273.9

11.9


CONCRETE

26'

273.9

CONC. DRIVE
S 17.47 E

DONALD N. HIKAY BAUN - ANNA LOUISE SMITH - MARILYN C. MOORE -

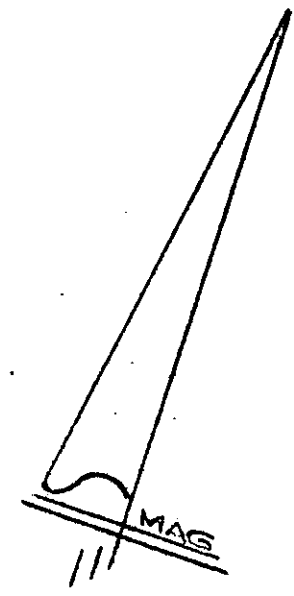


Note: Improvements on this lot are not in a flood hazard area.

OCT 3 1979

11387

7-R-18

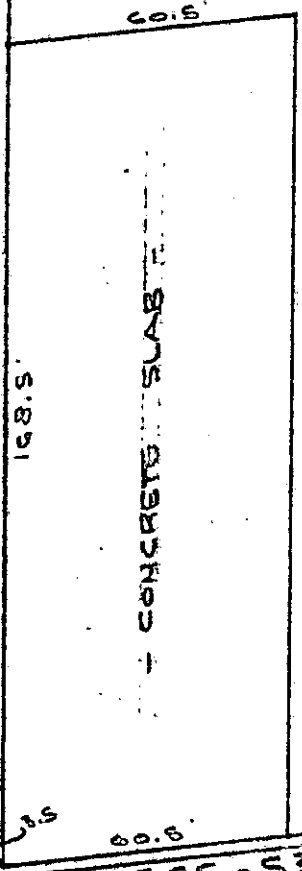

EXISTING BUILDING

CONCRETE SLAB

108.5

60.6

GCTO --- 1 OCT 3 79 1423

EAST CURTIS STREET
WATER & SEWER IN ST. R/W

PROPERTY OF
MC SHENDA INC.
SIMPSONVILLE, SOUTH CAROLINA
PLAT 302

This is to certify that on the 2nd day of October, 1979, I surveyed the property shown on this plat, being known as PROPERTY OF McSHENDA, INC. and recorded in the RMC Office Greenville County, S. C., in Plat Book _____ at Page _____; and that the property lines, walls and buildings are as shown hereon, and that the walls and buildings located on said lot do not encroach or project on adjacent street or property, and that no adjacent walls or buildings encroach or project on said premises, and no power lines cross this property except as shown hereon.

CAROLINA SURVEYING CO.
112 Manly St.
Greenville, S. C.

R. B. Bruce
R. B. Bruce, RLS #1952

3.0001

218/17

318-3-788